Township No. 41 N. Range No. 24 W. Mer. Mich.

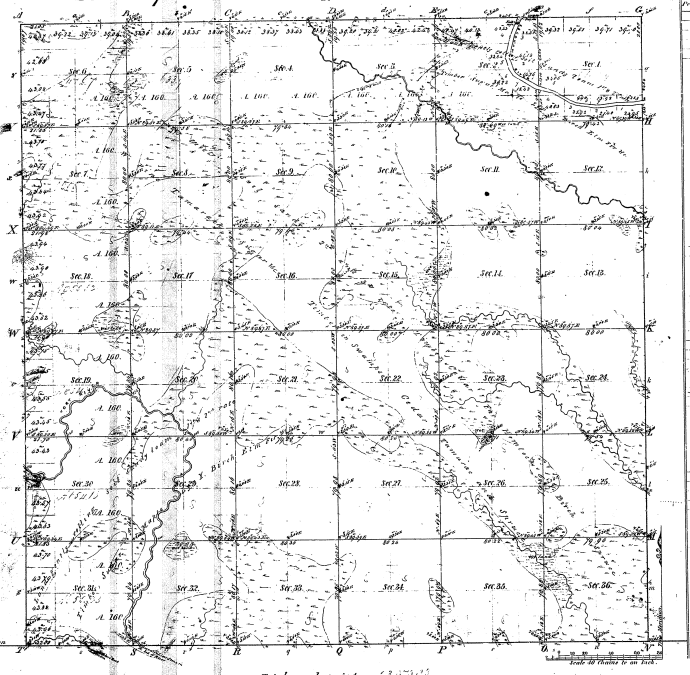

Meanders of

Prairie	Courses	Ch's & L's	Prairie	Courses	Ch's & L's	Prairie	Courses	Ch's & L's

38-37

38-37

Total number of Acres 23,045.65

Surveys Designated	By Whom Surveyed	Date of Contract	Amount of Surveys	When Surveyed	Plats & Notes and diff. in the last Town. rec'd.
Township lines	Jno. Rollin Bush	Sept. 7 1846	74 62	2nd Quar. 1847	
Subdivisions	E.C. Martin	Bond Dec. 3 1852	93 58	2nd Quar. 1852	

The above Map of Township 41 North of Range 24 West of the Principal Meridian Michigan is strictly conformable to the field notes of the survey thereof on file in this Office, which have been examined and approved.

Surveyor Generals Office, Detroit December 3 1853.

Lucius Chapman Surv. Gen.l