Township No. 42 N Range No. 22 W Mer. Mich.

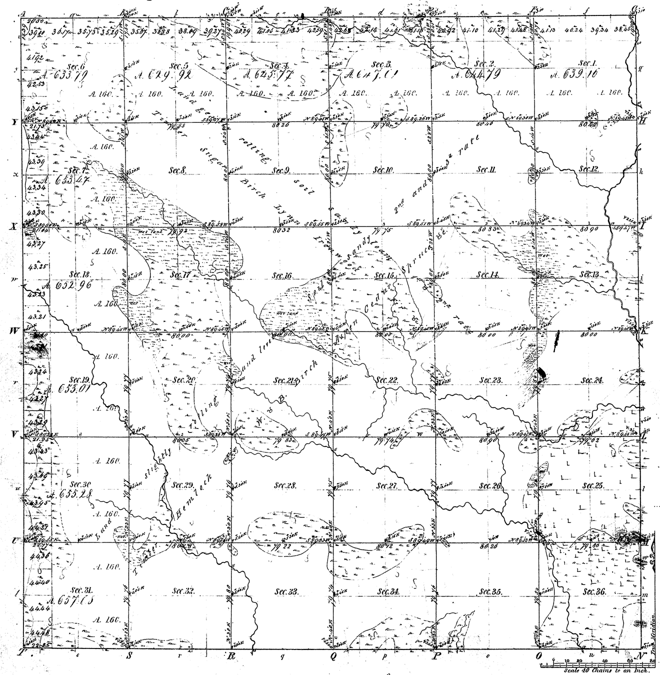

Total number of Acres. 23.113.44

Surveys Designated	By Whom Surveyed	Date of Contract	Amount of Surveys	When Surveyed	When pd. for and chd. in the Sur. Genl's acct.
Township lines	John Burt	Feby. 6th 1845	M. 12 Chs. 01 Lks. 25	2nd Quar. 1845	
Subdivisions	E. C. Martin	Bond Decr 3. 1851	60 07 24	3d Quart. 1852	

The above Map of Township No. 42 North of Range No. 22 West of the Principal Meridian Michigan is strictly conformable to the field notes of the survey thereof on file in this Office, which have been examined and approved.

Surveyor General's Office.
Detroit November 8th 1853

Leander Chapman
Sur. Genl.

Meanders of								
Posts	Courses	Ch. Lk.	Posts	Courses	Ch. Lk.	Posts	Courses	Ch. Lk.
38 34								

38-34