Township No. 43 N. Range No. 20 West. Mer. Mich.

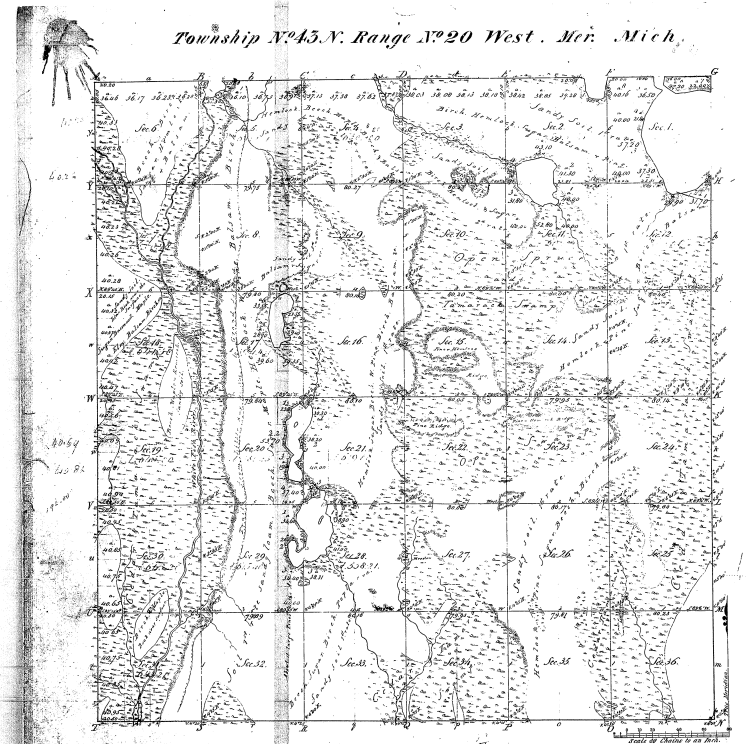

Total number of Acres 22,293.72

Surveys Designated.	By Whom Surveyed.	Date of Contract.	Amount of Surveys at $2.50 per	When Surveyed.	When Charged in the Surveyor's acct
Township lines	[illegible]	[illegible]	[illegible]	[illegible]	[illegible]
Subdivisions	A. Morrison & Son	June 6 1849	55.82.32	3rd Qr. 1849	

The above Map of Township No. 43 North of Range No. 20 West of the Principal Meridian, Mich. is strictly conformable to the field notes of the survey thereof on file in this Office, which have been examined and approved.

Surveyor Generals Office, Detroit Feb. 20. 1850

Wm. Noble Surv. Genl

Boundary of Town. Between 19 & 20 Town. Between 19 & 20

37-24

37-25

13.41 23.6 [illegible] 10.62.62