38-23

Township No. 43 N Range No. 22 W Mer. Mich.

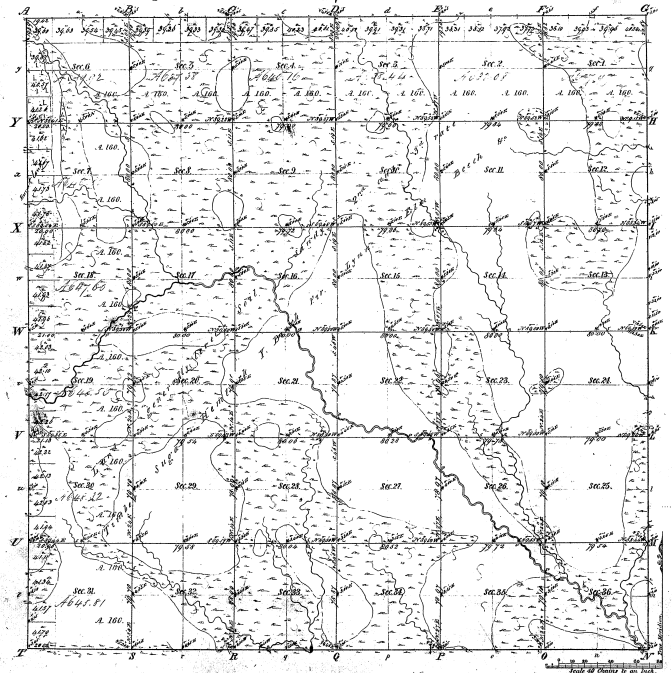

Meanders of								
Posts	Courses	Ch.s	Posts	Courses	Ch.s	Posts	Courses	Ch.s
38	23							

Total number of Acres. 23.063.04

Surveys Designated	By Whom Surveyed	Date of Contract	Amount of Surveys	When Surveyed	When g.d Or and ch.d in the Sur.r Gen.l Ass.t
Township lines	W. A. Burt	April 1st 1841	M. D. Ly. / 4 D. 7	3d Quar. 1841	
Subdivisions	Alfred Millard	Bond Feb. 18 1852	59 66	3d Quar. 1852	

The above Map of Township No. 43 N. of Range No. 22 W. of the Principal Meridian of Michigan is strictly conformable to the field-notes of the survey thereof on file in this Office which have been examined and approved.

Surveyor General's Office
Detroit May 26th 1854

Leander Chapman
Sur.r Gen.l