Township. N.o 43. N. Range. N.o 23 W. Mer.. Mich.

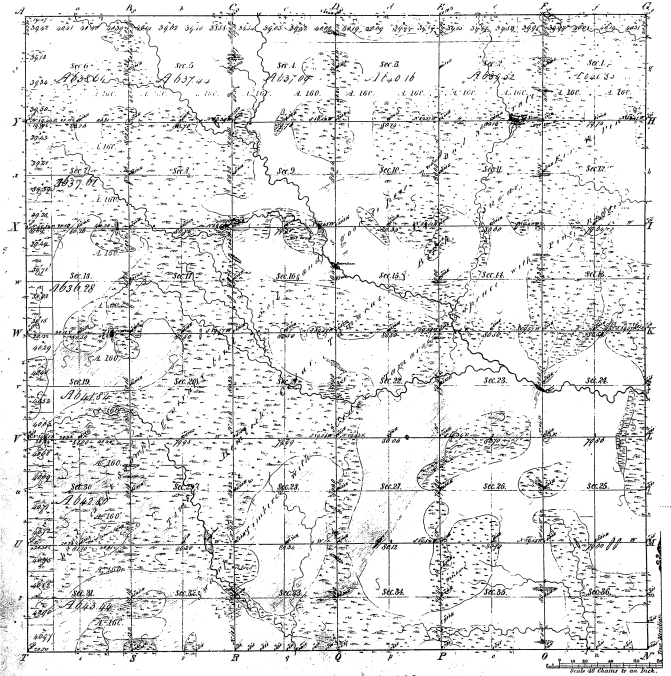

Meanders of

36 1

38

Total number of Acres 23035.37

Surveys Designated.	By Whom Surveyed	Date of Contract	Amount of Surveys	When Surveyed	Whether one and which is the Init. Gen.l mer.
Township lines	W.m A. Burt	April 1st 1843	70 00 00	3rd Quar. 1845	
Subdivisions	Marvin M. Hall	Bond Dec 29. 1845	60 13 40	2nd Quar. 1846	

The above Map of Township N.o 43 N. of Range N.o 23 W. of the Principal Meridian of Michigan, is strictly conformable to the field notes of the survey thereof on file in this Office, which have been examined and approved.

Surveyor Generals Office
Detroit 2nd day of June 1846.

Lucius Lyon
Surv.r Gen.l