


Township 1° 39' N. Range 1° 28' W. Mer. Mich.

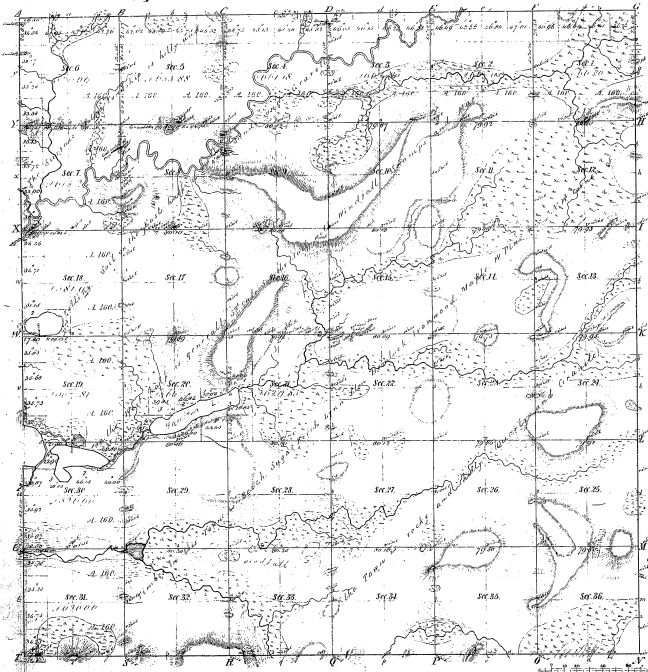

Total number of acres 7802.33

Survey designated	By whom surveyed	Date of Contract	Amount of Survey	When Surveyed	Quantity not sold in the Survey to what
Township 13th	James H. Weston	June 22 1842	66 1/2 Secs	1842-1843	11 1/2
Subdivisions	James H. Weston	June 27 1842	66 1/2 Secs	1842-1843	3 3/4

The above Map of Township 13-39 North of Range 13-28 West of the Principal Meridian Michigan is a true and correct copy of the original survey on file in this Office which have been examined and approved.

Surveyor General's Office
Detroit April 10 1858

Charles D. Little
Supt. Genl.

Number of	Perch Courses 1842	Perch Courses 1843	Perch Courses 1844
46-27			

46-29