Township N.º 39 N. Range N.º 31 W. Mer. Mich.

WISCONSIN.

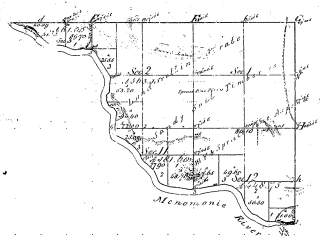

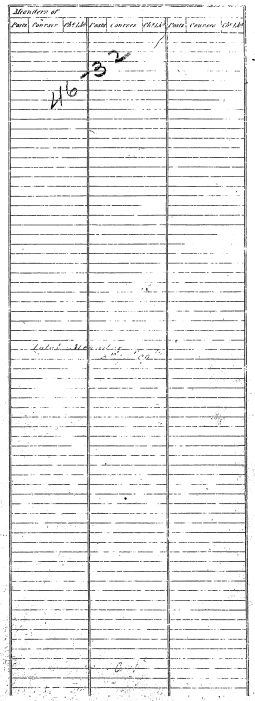

46-32

46-31

Total Number of Acres 1911.15

Surveys Suspended	By Whom Surveyed	Date of Contract	Amount of Contract	When Surveyed	When Changed in the Boundaries &c.
Township lines	Wm. Mullett	June 7th 1844	[illegible]	1846	
Subdivisions	James H. Miller	June 27 1844	[illegible]	1847	

The above Map of Township No. 39 North of Range No. 31 West of the Principal Meridian, Michigan, is strictly conformable to the field notes of the survey returned to this office, which have been examined and approved.

Surveyor General's Office, Detroit, [illegible]

Asst. Genl.

Scale 40 Chains to an Inch.