


Township 41° N. Range 30° W. Mer. Mich.

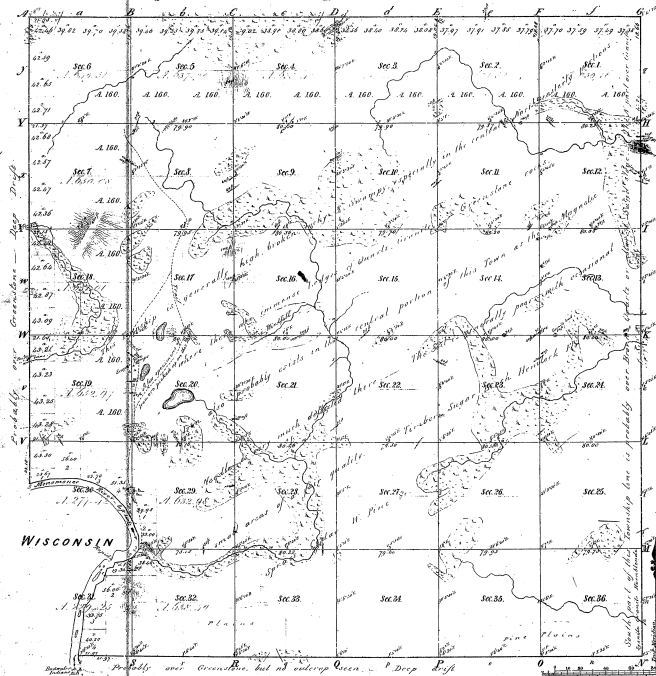

Survey designated	By whom surveyed	Date of Contract	Amount of survey	When Surveyed	Range of land as to the Sec. Cont. and
Township 41 N	M. C. D. & B. Co.	April 27, 1854	36 Secs.	1854	1/4 Range 30 W
Subdivisions	John D. Baird	April 27, 1859	36 Secs.	1859	1/4 Range 30 W

Total number of Acres 2,250.00

The above copy of Township 41 N. Range 30 West of the Principal Meridian, Michigan, is hereby confirmed, to the full extent of the survey thereof, for the following which have been examined and approved:

Surveyor General's Office
 Charles Foster
 Detroit, March 10, 1860

41° 39'						
Alexander						
E. W. W. 1854, 1856						

4539