Township No. 42 N. Range No. 29 W. Mer. Mich.

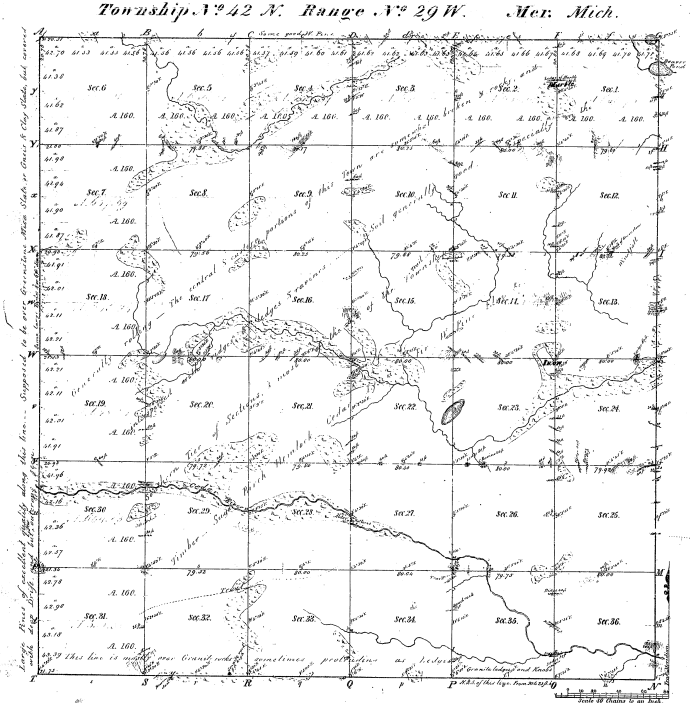

Meanders of

Posts	Courses	Ch. Lk.	Posts	Courses	Ch. Lk.	Posts	Courses	Ch. Lk.
45-35								

45-35

Total number of Acres. 23152.27

Surveys Designated	By Whom Surveyed	Date of Contract	Amount of Surveys	When Surveyed	When p.d. for and ch.d. of the Sur. Gen.l's acct.
Township lines	Martin W.m A. Burt, & P. Burt	Sept. 7. 1846	M. Ch. Lks. 12. 02. 01	4th Quar. 1846 & 1st Quar. 1847	
Subdivisions	John Burt	April 27. 1849	50. 07. 67	3d Quar. 1849	

The above Map of Township No. 42 North of Range No. 29 West of the Principal Meridian Michigan is strictly conformable to the field notes of the survey thereof on file in this Office, which have been examined and approved.

Surveyor General's Office.
Detroit Mar. 15 1850

Charles Noble
Sur. Gen.l

Carl Copy made
Ry. Copy made