Township. N.º 43 N. Range. N.º 28 W Mer. Mich.

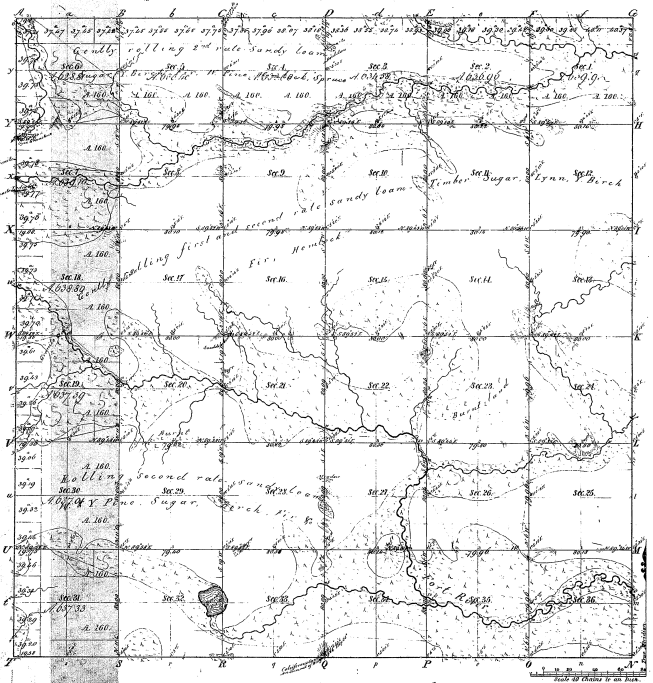

Meanders of

Poste	Courses	Ch'ls	Poste	Courses	Ch'ls	Poste	Courses	Ch'ls

45-29

Total number of Acres 22 901.86

Surveys Distinguished	For Whom Surveyed	Date of Contract	Amount of Surveys	When Surveyed	When Plats and Fd Notes in the Surv. Gen.l Office
			M. Ch's Lks.		
Township lines	1st & 2d Rang's	Sept.r 7 1847	59 77 01	3rd Quar. 1850	
Subdivisions	1st & 2d Rang's	April 26 1850	59 77 01	3rd Quar. 1850	

The above Map of Township N.º 43 North of Range N.º 28 West of the Principal Meridian Michigan is strictly conformable to the field notes of the survey thereof on file in this Office, which have been examined and approved.

Surveyor Generals Office
Detroit June 4th 1851

Charles Noble
Surv.r Gen.l