Township N.o 44 N. Range N.o 29 W. Mer. Mich.

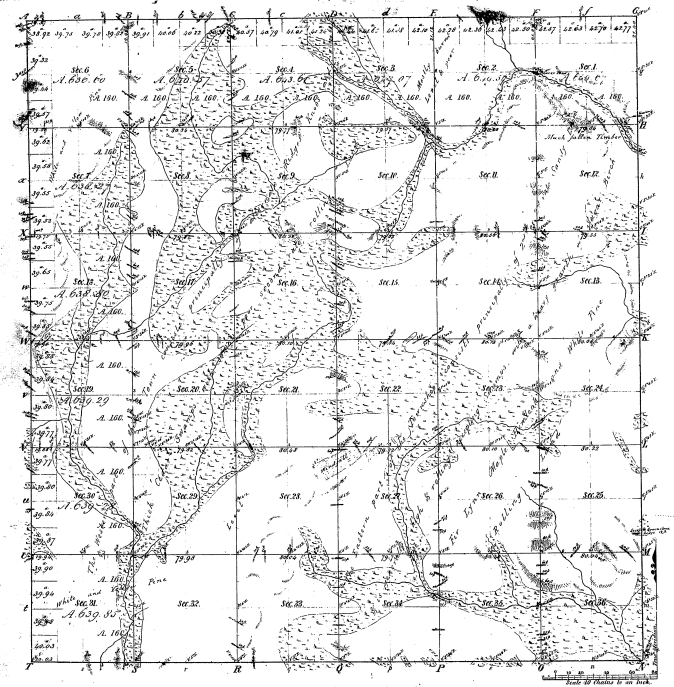

Meanders of

North Courses	West	South Courses	West	South Courses	East

45.27

Total number of Acres 23063.38

Surveys Designated	By Whom Surveyed	Date of Contract	Amount of Surveys	When Surveyed	When the Lines and Cor.s were Established
Township Lines	[illegible]	[illegible]	M. CH. LS.	2nd 1826	
Subdivisions	John Burt	Contd. 23d May	60. 02. 79	1827 & 1828	

The above Map of Township No 44 North of Range No 29 West of the Principal Meridian Michigan is strictly conformable to the field notes of the survey thereof on file in this Office which have been examined and approved.

Surveyor Generals Office. Detroit March 15th 1829

Lucius Lyon, Surv.r Gen.l

Examined Corrected Platted Approved