Township No. II north, Range No. V west (excl. Ter.)

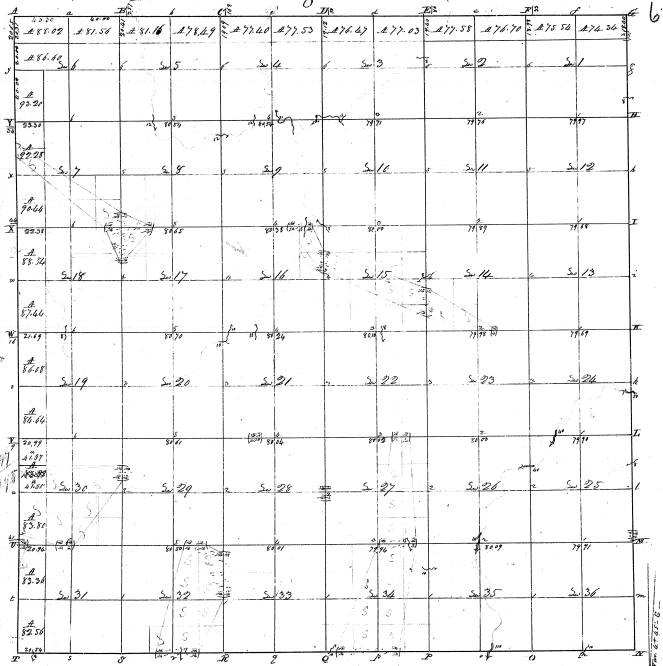

Surveyed in October 1825 by Sylvester Sibley D.S.

Mr. N. to 1	74	34		Su. 19	320		
Su. " "	80			G. N.W. "	80		
Mr. N.W. "	75	54		Mr. " "	84	08	
Su. " "	80			En. S.W. "	80		
Su. " "	320			Mr. " "	84	66	
Mr. N. to 2	74	70		Su. 20	640		
Su. " "	80			Su. 21	640		
Mr. N.W. "	77	58		Su. 22	640		
Su. " "	80			Su. 23	640		
Su. " "	320			Su. 24	640		
Mr. N. to 3	77	03		Su. 25	640		
Su. " "	80			Su. 26	640		
Mr. N.W. "	76	47		Su. 27	640		
Su. " "	80			Su. 28	640		
Su. " "	320			Su. 29	640		
Mr. N. to 4	77	53		En. 30	320		
Su. " "	80			En. N.W. "	80		
Mr. N.W. "	77	40		Mr. " "	83	92	
Su. " "	80			En. S.W. "	80		
Su. " "	320			Mr. " "	83	80	
Mr. N. to 5	78	49		En. 31	320		
Su. " "	80			En. N.W. "	80		
Mr. N.W. "	81	16		Mr. " "	83	36	
Su. " "	80			En. S.W. "	80		
Su. " "	320			Mr. " "	85	55	
Mr. N. to 6	81	56		Su. 32	640		
Su. " "	80			33	640		
Mr. N.W. "	88	02		34	640		
Su. " "	84	60		35	640		
Su. " "	160			36	640		
En. S.W. "	80				15546	31	
Mr. " "	93	20			15560	62	
En. 7	320				23104	98	
En. N.W. "	80						
Mr. " "	92	25					
En. S.W. "	80						
Mr. " "	90	66					
Su. 8	640						
Su. 9	640						
Su. 10	640						
Su. 11	640						
Su. 12	640						
Su. 13	640						
Su. 14	640						
Su. 15	640						
Su. 16	640						
Su. 17	640						
En. 18	320						
En. N.W. "	80						
Mr. " "	88	86					
En. S.W. "	80						
Mr. " "	87	66					
	15560	62					