Township N. III North, Range N. V West (Mich. Ten)

6-29

50

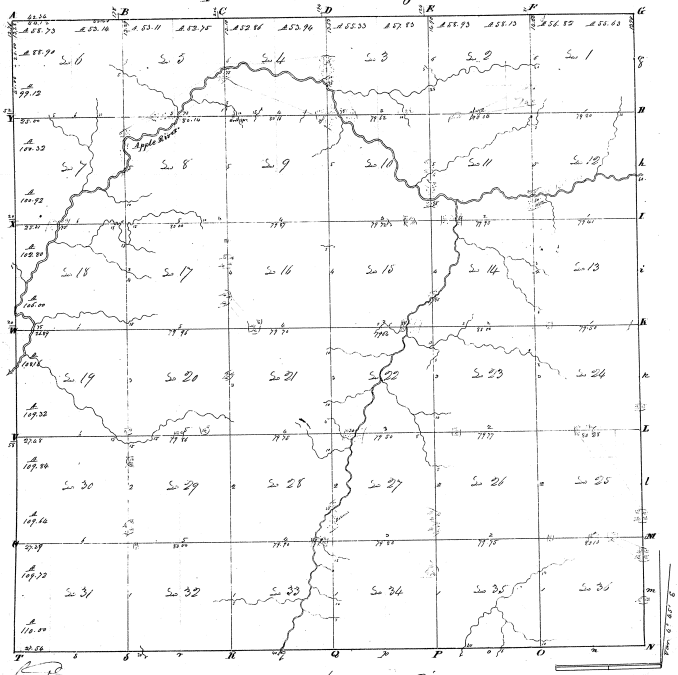

Comp.

Surveyed in Nov. & Dec. 1826 by Orange Risdon

N. N. E. 1	55	63		Sec. 20	640		
Sx	80			21	640		
N. N. W.	56	82		22	640		
Sx	80			23	640		
Sx	320			24	640		
N. N. E. 2	58	13		25	640		
Sx	80			26	640		
N. N. W.	58	93		27	640		
Sx	80			28	640		
Sx	320			29	640		
N. N. E. 3	57	83		Ex. 30	320		
Sx	80			Ex. N. W.	80		
N. N. W.	55	33		M.	109	84	
Sx	80			Ex. S. W.	80		
Sx	320			M.	109	64	
N. N. E. 4	53	94		Ex. 31	320		
Sx	80			Ex. N. W.	80		
N. N. W.	52	86		M.	109	72	
Sx	80			Ex. S. W.	80		
Sx	320			M.	110		
N. N. E. 5	52	75		Sec. 32	640		
Sx	80			33	640		
N. N. W.	53	11		34	640		
Sx	80			35	640		
Sx	320			36	640		
N. N. E. 6	53	14			10998	76	
Sx	80				12042	74	
N. N. W.	58	73			23041	96	Total
Sx	88	90					
S. E.	160						
Ex. S. W.	80						
M.	99	12					
Ex. 7	320						
Ex. N. W.	80						
M.	100	32					
Ex. S. W.	80						
M.	100	92					
Sec. 8	640						
9	640						
10	640						
11	640						
12	640						
13	640						
14	640						
15	640						
16	640						
17	640						
Ex. 18	320						
Ex. N. W.	80						
M.	102	80					
Ex. S. W.	80						
M.	106						
Ex. 19	320						
Ex. N. W.	80						
M.	108	16					
Ex. S. W.	80						
M.	109	32					
	12042	74					