


Township N. 34 Range W. 6 Mer.


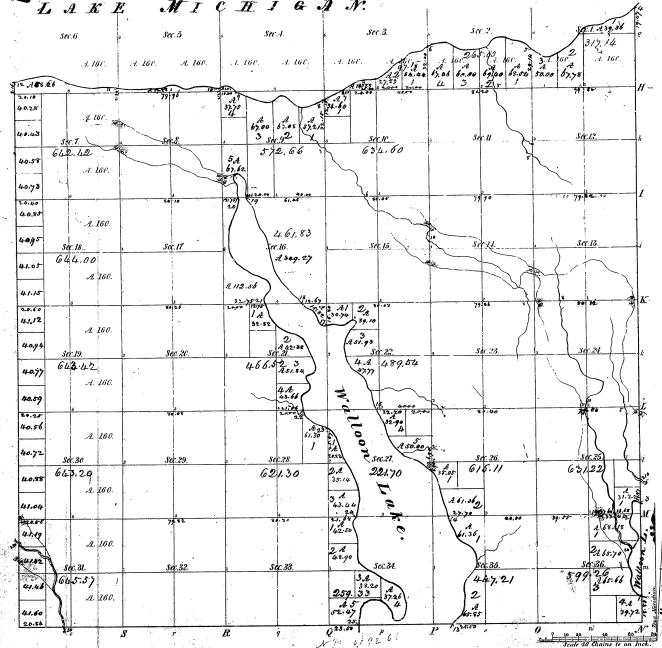


18-9




