Township No. 35 N. Range No. 6 W. Mer.

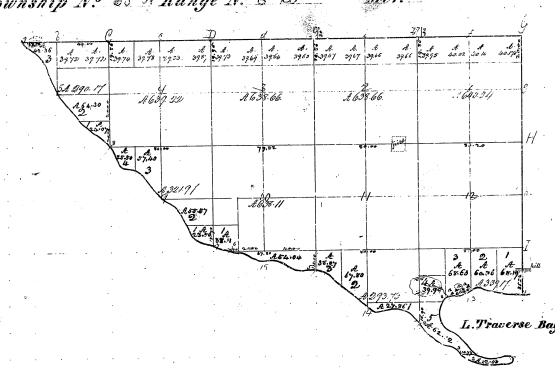

Meanders of Lake Michigan on the Township Line

Per.	Course	Dist.	Chains	Course	Dist.	Chains	Course	Dist.
1	N 38 W	13.50						
	N 77 W	17.00						
	N 70 W	22.00						
	S 82 W	6.00						
	S 68 W	3.00						
	S 50 W	7.00						
	S 10 W	9.00						
	S 30 E	6.00						
	S 52 E	5.00						
	S 65 E	4.00						
2	S 45 E	20.00						
	S 15 E	4.00						
	S 31 E	6.00						
	S 55 E	3.00						
	S 52 E	4.00						
	S 73 E	5.00						
	S 83 E	7.00						
	S 45 E	4.00						
	N 60 E	12.00	meets Lake Michigan					
	N 77 W	7.00						
3	N 70 W	6.00						
	N 61 W	4.00						
	N 70 W	14.00						
	N 80 W	16.00						
4	N 62 W	8.00						
	N 52 W	15.00						
	N 71 W	15.00						
	N 52 W	14.00						
	N 72 W	14.00						
5	N 72 W	13.00						
	N 77 W	14.00						
	N 84 W	17.00						
	N 80 W	10.00						
	N 78 W	10.00						
	N 78 W	11.00						
6	N 77 W	8.50						
	N 78 W	7.00						
7	N 80 W	6.10						
	N 79 W	18.00						
	N 84 W	18.50						
	N 87 W	21.00						
	N 85 W	28.50						
	N 77 W	18.00						
8	N 74 W	16.00						
	N 71 W	18.00						
	N 80 W	18.00						
	N 74 W	18.00						
9	N 65 W	23.60						

19-26

14-6

Total number of acres 5786.05

Surveys Designated.	By Whom Surveyed.	Date of Contract.	Amount of Surveys. M.	Ch.	L.	When Surveyed.	When Charged in the Surr-Genl's Office.
Township lines.	John Mullett	Jun. 15 1840	10	77	12	8th Jy 1840	4th Jy 1841
Subdivisions.	Dennis	Aug 11	03	58	11	5	4th Jy 1840

The above Map of Township No. 35 N. of Range No. 6 W. of the Principal Meridian Michigan is strictly conformable to the field notes of the survey thereof on file in this Office and has been accepted and approved.

Surveyor General's Office

Cincinnati Oct. 2 1841

C. C. Trowbridge Surr Genl