


Township N. VI north, Range N. VI east 110r. (M. Tor.)

112

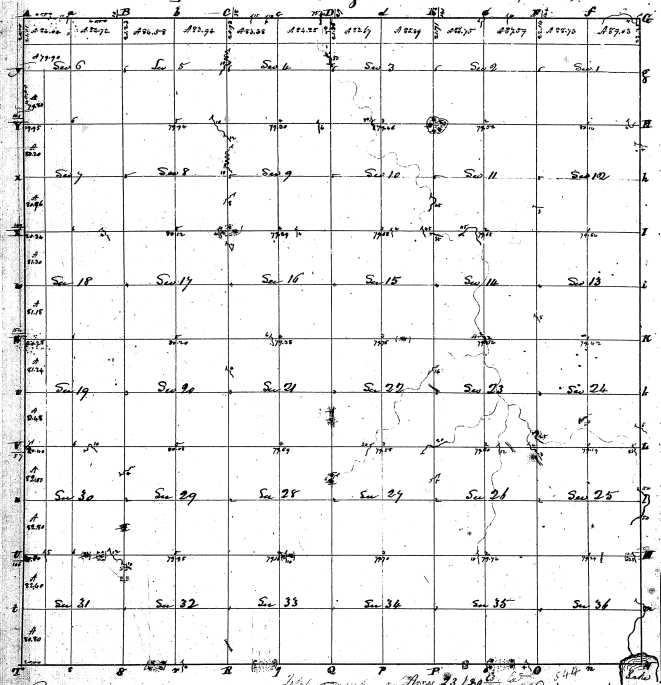

28-10

31-32

