


Township N. VI north, Range T. VIII east 11th Mer. (11th Mer.)

32

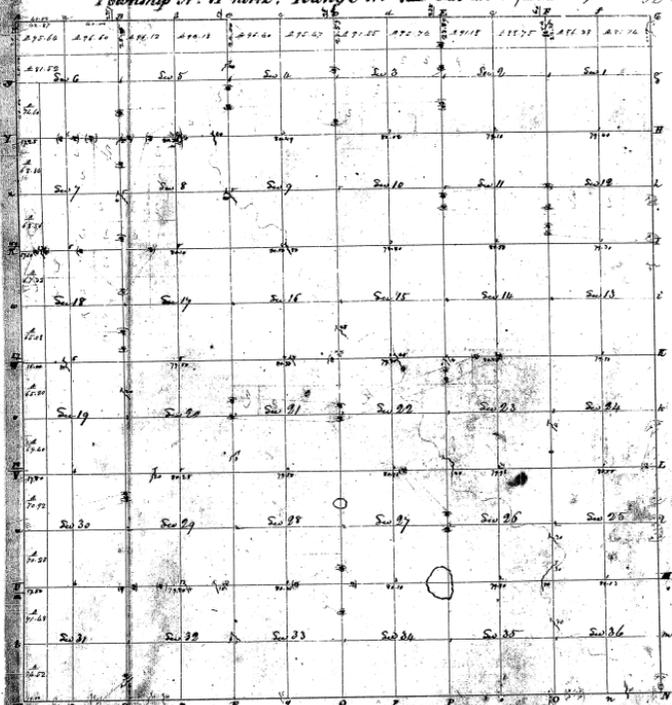

28-20

28-20

23.978.07

 H. Wampler D. C.