


Township N. 17 North, Range N. 5 East Mer. (M. Tor.)

37

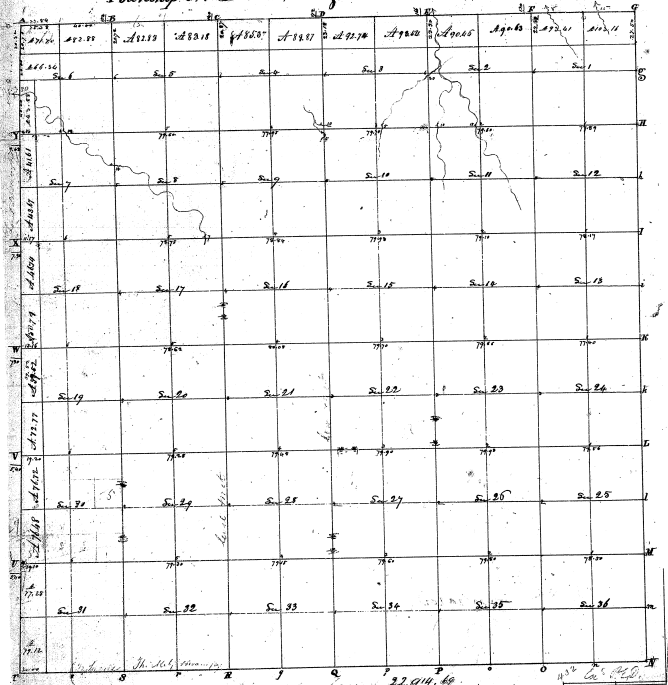

28-16

28-16

22,914, 89
 Pursuant to a contract with and instructions from General Office Agents
 Survey General of the State of Ohio bearing date the 5th day of February 1821. I have examined
 said contract and maps of the above divided Township, and do hereby certify that it had such marks and
 found the same to be correct as are represented on said plat and described in the field
 notes and that I returned with the plat into the Survey General's Office of
 Columbus the 11th day of January 1822
 Horton Bull