


Township 3rd T. Range 3rd R. East of 9th W. (with 10th)

15

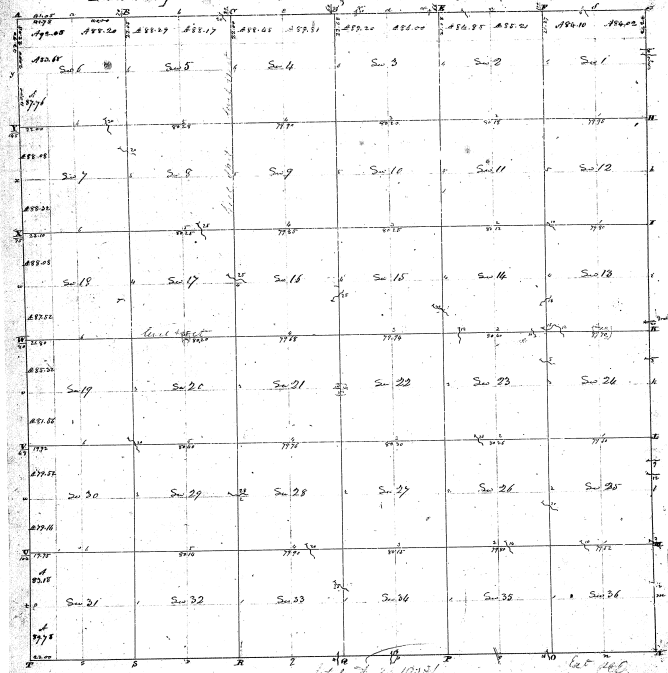

28-7

28-7

with this plat into the Survey General's Office.

Witness my hand and seal this 17th day of January 1892.

Horatio Wall, Reg.