Re survey

Township N° 18 N. Range N° 2 E. Mer. Mich.

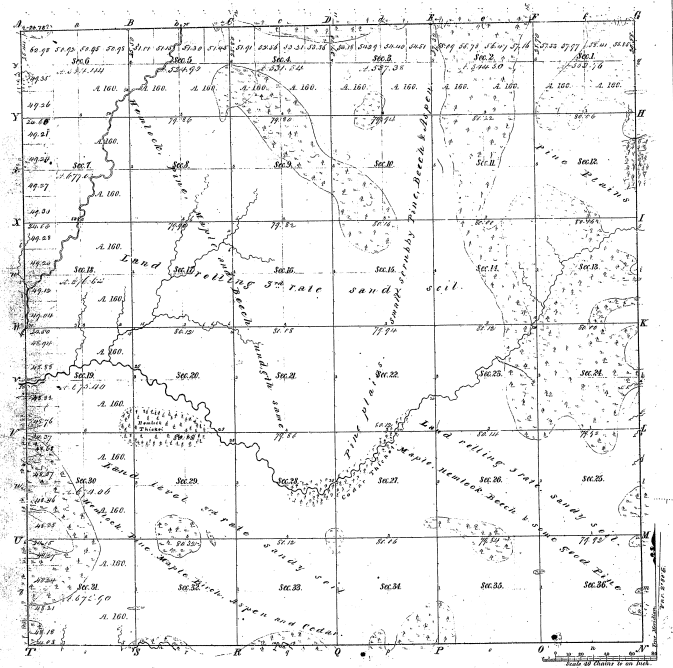

Meanders of

Posts	Courses	Dist.	Posts	Courses	Dist.	Posts	Courses	Dist.

23

Total number of Acres 23021.54

Surveys Designated	By Whom Surveyed	Date of Contract	Amount of Surveys	When Surveyed
Township lines	Lucius Lyon	Sept. 29. 1834		1835
Subdivisions	John Mullett	Feby 14. 1835	23 21 54	1836
	W. Hoyt Jr.	Feb. 17. 1836	6 00 00	1837

The above Maps of Township N° 18 North, of Range N° 2 East of the Principal Meridian Michigan, is strictly conformable to the field notes of the survey thereof on file in this Office, which have been examined and approved.

Surveyor Generals Office
Detroit August 4th 1836

Lucius Lyon
Surv. Genl