


Re Survey
Township 1° 20' N. Range N° 2 East Mer. 11th.

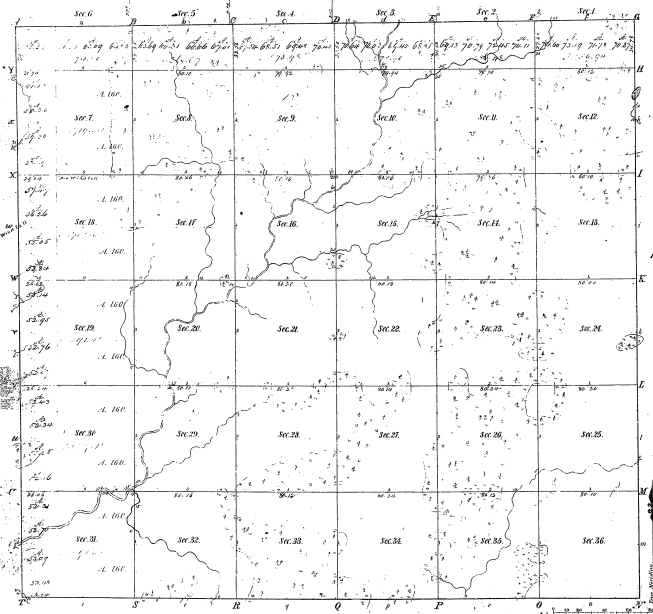

Boundaries of
 (Cont) Course 1821 (Part) Course 1822 (Part) Course 1823

<p style="font-size: 2em; text-align: center;">23-3</p>	
---	--

Total number of Acrs. 2116.91

Survey Designated	By Whom Surveyed	Date of Contract	Amount of Survey	When Surveyed	When	When




