Township No. 43 N. Range No. 39 West. Mer. Mich.

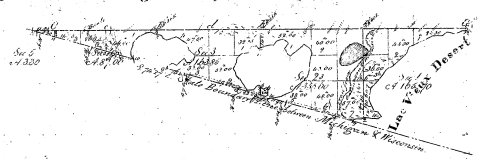

WISCONSIN.

Meanders of								
Fwd	Courses	Ch. Lks	Fwd	Courses	Ch. Lks	Fwd	Courses	Ch. Lks
43-38								
			Meanders					
			Dec. Ch. Lks					
			5 23 82					

Scale of Chains to an Inch

Total number of Acres 775 45

Surveys Suspended	Date When Surveyed	Date of Contract	Amount of Surveys M. Chs. Lks	When Surveyed	When Charged to the Surv. Genl. acct.
Township Lines	H. & C. Rust	[illegible]	1 47	3rd Quart 1867	
State boundary	H. & C. Rust	[illegible]		[illegible]	
Subdivisions	Wm. Rust	April 11th 1868	6 37 94	3rd Quart 1867	

The above Map of Township No. 43 N. North of Range No. 39 West of the Principal Meridian Michigan is strictly conformable to the field notes of the survey thereof on file in this Office and is hereby approved and approved

Surveyor General's Office
Detroit Mich. 2d 1858

Chas. Ashton Jun. Genl.

43-38