


Township N<sup>o</sup> 47N. Range N<sup>o</sup> 42W. Mer. Mich.

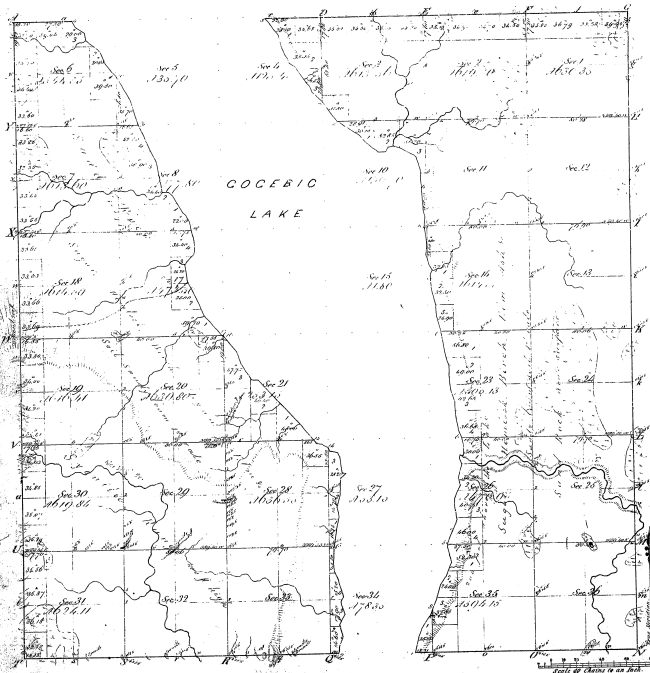




The above Map of Township N<sup>o</sup> 47, Range N<sup>o</sup> 42, Mer. Mich. of the  
 correct of the survey being on file in this Office, and has been examined and approved.  
 Surveyor General's Office  
 Detroit, Dec 18, 1847  
 Charles L. Latta, Sur. Genl.