42-24

Township No. 47 N. Range No. 43 W. Mer. Mich

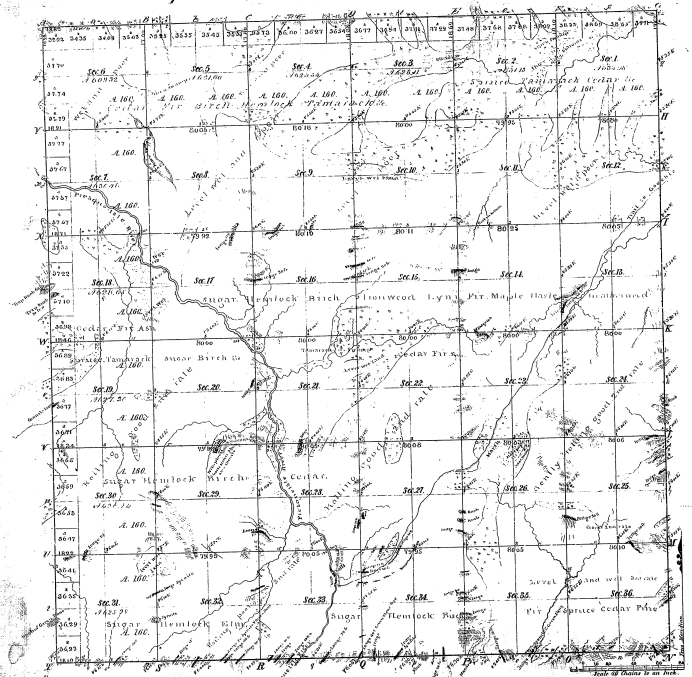

Total number of Acres. 22,886.53

Meanders of									
Poste	Courses	Ch.s Lks	Poste	Courses	Ch.s Lks	Poste	Courses	Ch.s Lks

Survey Designated	By Whom Surveyed	Date of Contract	Amount of Surveys	When Surveyed	When pr. Ds. and Ch.s in the Sur. Gen.l Off. acc.d
Township lines	Wm. Burt	April 27 1844	M. Ch.s Lks. 11 17 72	3rd Qr. 1845	
Subdivisions	William Burt	March 2nd 1846	52 65 00	3rd Qr. 1846	

The above Map of Township No. 47 North of Range No. 43 West of the Principal Meridian Michigan is strictly conformable to the field notes of the survey thereof on file in this Office, which have been examined and approved.

Surveyor General's Office
Detroit Jany. 27. 1849

Lucius Lyon, Sur. Genl.