Township N.o 47 N. Range N.o 47 W. Mer. Mich.

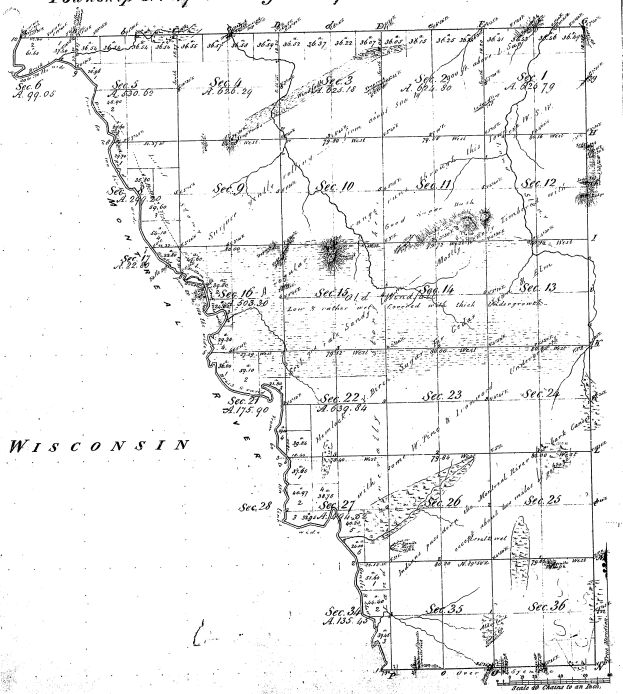

Meanders of							
Pass	Courses	Dist Lks	Pass	Courses	Dist Lks	Pass	Courses	Dist Lks

"Total number of Acres 13722.74"

Survey Designated.	By Whom Surveyed.	Date of Contract.	Amount of Surveys		When Accepted	When Returned to the Surveyor Gen.l Office
			M.	Chs Lks		
Township lines	Wm. A. Burt & Alex.r Stuart	April 7th 1847	15.	80.	2nd Sep.r 1847	
Subdivisions	Wm. A. Burt	Novem.r 12 1847	46.	34. 70.	2nd Dec.r 1847	

The above Map of Township N.o 47 North of Range N.o 47 West of the Principal Meridian Michigan is strictly conformable to the field notes of the survey hereof on file in this Office, which have been examined and approved.

Surveyor General's Office
Detroit Dec.r 9th 1847

Surveyor Gen.l Dep.y Surv.r Gen.l

2-28-54