Township No. 48 N. Range No. 45 W. Mer. Mich.

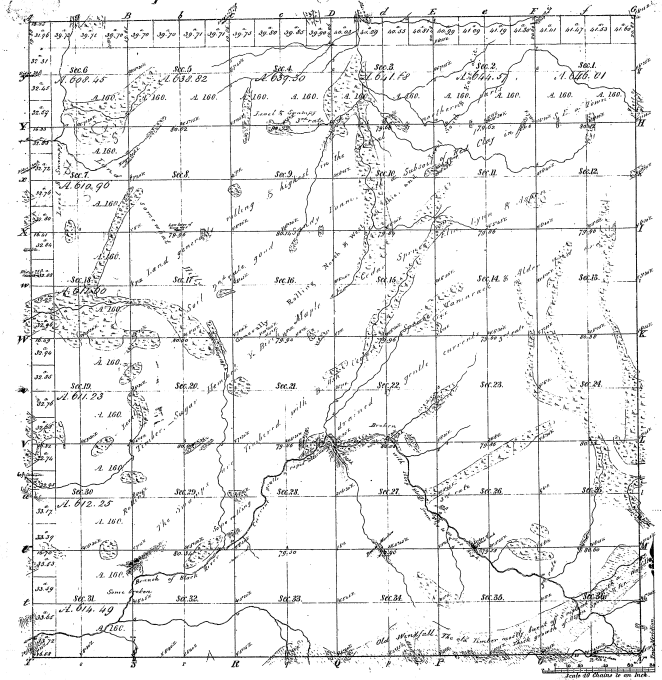

Meanders of								
Posts	Courses	Ch. Lk.	Posts	Courses	Ch. Lk.	Posts	Courses	Ch. Lk.

42-19

42-19

Total number of Acres. 22879.36

Surveys Designated	By Whom Surveyed	Date of Contract	Amount of Surveys	When Surveyed	Whom Surveyed for and ch. in the Surv. Gen. Ofc.
Township lines	Wm. A. & Austin Bent	April 27th 1847	M. Ch. Lks. 71 77 76	Oct. 1847	
Subdivisions	Austin Bent	April 27th 1848	30 67 62	1848	

The above Map of Township No. 48 North of Range No. 45 West of the Principal Meridian Michigan, is strictly conformable to the field notes of the survey thereof on file in this Office, which have been examined and approved.

Surveyor General's Office
Detroit March 3 1849

Lucius Lyon Surv. Genl.

(Coml. Copy [illegible])
[illegible]