Township No 48 N. Range No 48 W. Mer: Mich.

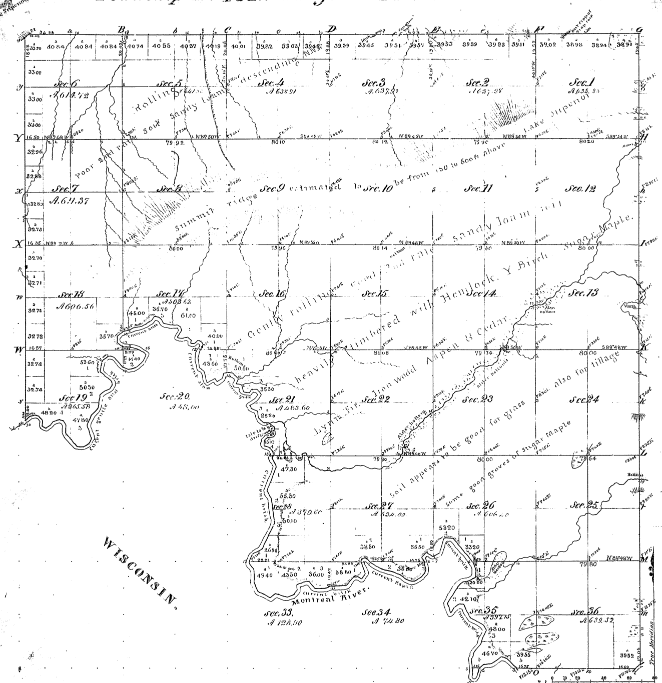

Meanders of					
Posts. Courses	Ch. Lks.	Posts. Courses	Ch. Lks.	Posts. Courses	Ch. Lks.

Total number of Acres 17515.63

Surveys Designated.	By Whom Surveyed.	Date of Contract.	Amount of Surveys. M. Chs. Lks.	When Surveyed.	When Charged in the Surr. Genl's acct.
Township lines.	Wm A Burt Austin Burt	April 27th 1847	6 75 80	3rd Qr 1847	
Subdivisions.	William Ives	[illegible] 14 1848	58 57 89	3rd Qr 1848	
Also part South boundary Sec 35			5 76		

The above Map of Township No 48 North of Range No 48 West of the Principal Meridian, Michigan is strictly conformable to the field notes of the survey thereof on file in this Office, which have been examined and approved.

Surveyor General's Office,
Detroit Jany 10th 1849

Lucius Lyon Surr. Genl.

42-16

Township No. 47 N. Range No. 48 W. Mer. Mich.

WISCONSIN.

Meanders of									
Pass	Courses	Dist. L.B.	Pass	Courses	Dist. L.B.	Pass	Courses	Dist. L.B.

42-16 A

Meanders 1.55.56

Scale 40 Chains to an Inch.

Total number of Acres 118.00

Survey Designated.	By Whom Surveyed.	Date of Contract.	Amount of Surveys M. Ch. Lks.			When Surveyed.	When Changed in the Surveys or not.
Township lines.							
Subdivisions.	William Ives	Monday 22 Nov. 1847	2	16	15	July 29 1848	

The above Map of Township No. 47 North of Range No. 48 West of the Principal Meridian Michigan is strictly conformable to the field notes of the survey thereof on file in this Office which have been examined and approved.

Surveyor General's Office, Detroit January 12 1849

Lucius Lyon, Surv. Genl.

Registered Copy made