


Township N<sup>o</sup> 50 N. Range N<sup>o</sup> 45 W.

Mer. Mich.

Meander

LAKE SUPERIOR.

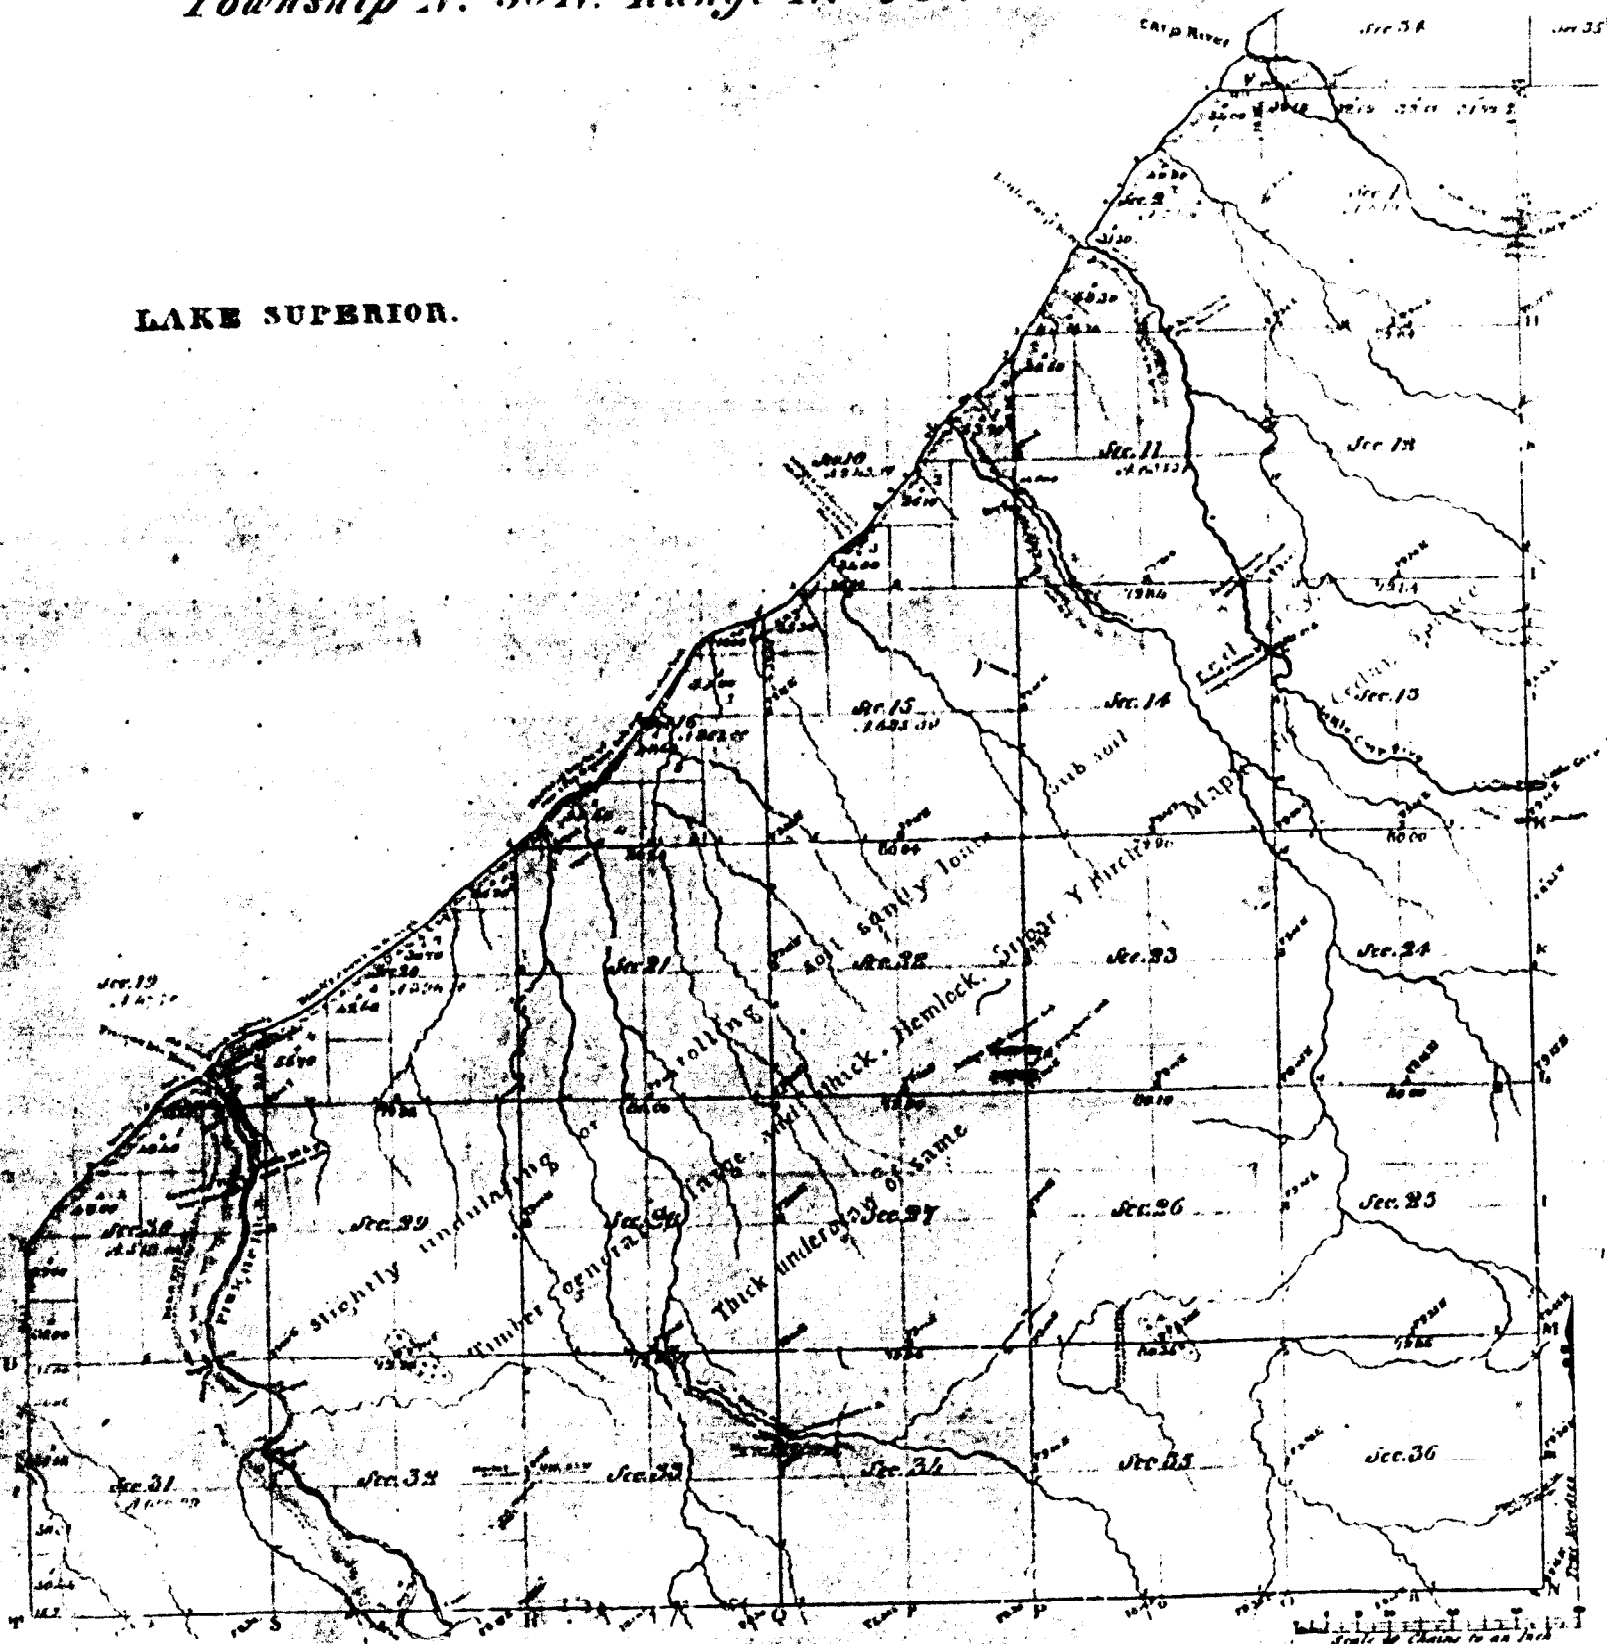

Total number of Acres 15256.20

Survey Designated	By Whom Surveyed	Date of Contract	Amount of Survey Ac. Cts. Ls.	When Surveyed	When changed in the Sur. Genl's Off.
Township lines	Wm A. Burt li	April 27 1827	11.71.19	1827	1867
Subdivisions	Austin Burt	Board Comrs 1828	47.66.63	1828	

The above Map of Township N. 50 North of Range N. 45 West of  
Principal Meridian, Michigan, is truly and correctly  
of the survey thereof on file in this Office, which have been examined and  
Surveyor General's Office,  
Detroit, March 5 1867

Lucius Lyon, Clerk