


Township N<sup>o</sup> 28 N. Range N<sup>o</sup> 10 West Mer. (Mich.)

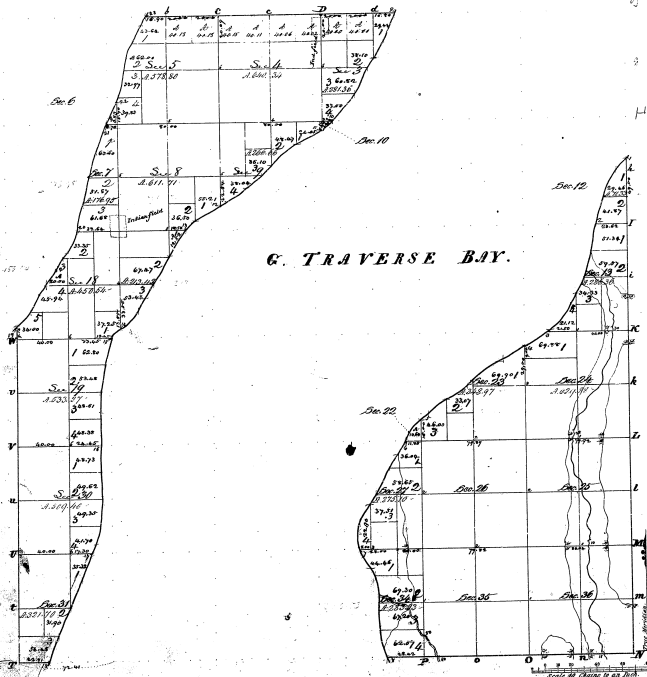

C. TRAVERSE BAY.


Total number of Acres 9,128.82

Survey	By Whom Surveyed	Date of Survey	Area of Survey	When Surveyed	When Closed or
Survey	John A. Hays	1-21-1839	16.26.26	27-28-1839	3-27-1839
Subdivisions			37.26.62		

This above Map of Township N<sup>o</sup> 28 N. of Range N<sup>o</sup> 10 West  
 of the Principal Meridian Michigan is a copy of the original  
