


Township N. IX north, Range N. I west Mer. (Mc. Tor.)

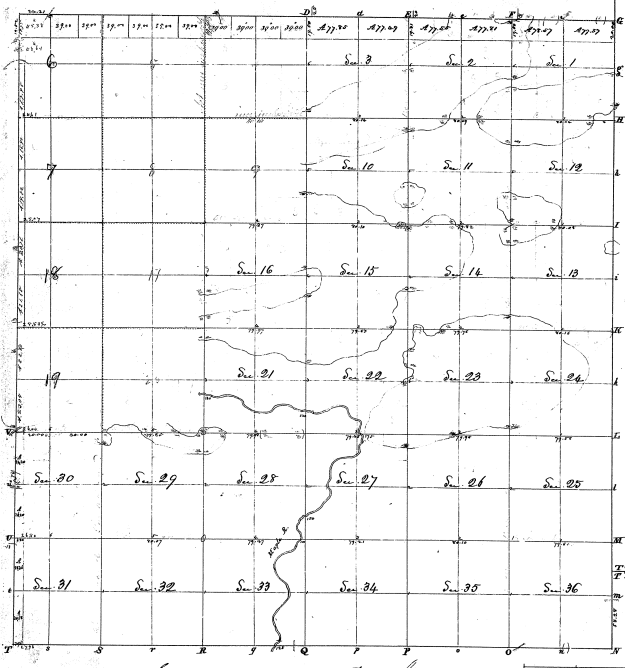

Surveyed in April, 1831, by Robert Sharnad, D. S.

 Robert Sharnad, Office Assistant, South 731 E. N. 7 William

29-312


account of Gov. S. Taylor's purchase

3-5

