Remeasurement of

Township № 9 N. Range № 2 W. Mer. Mich.

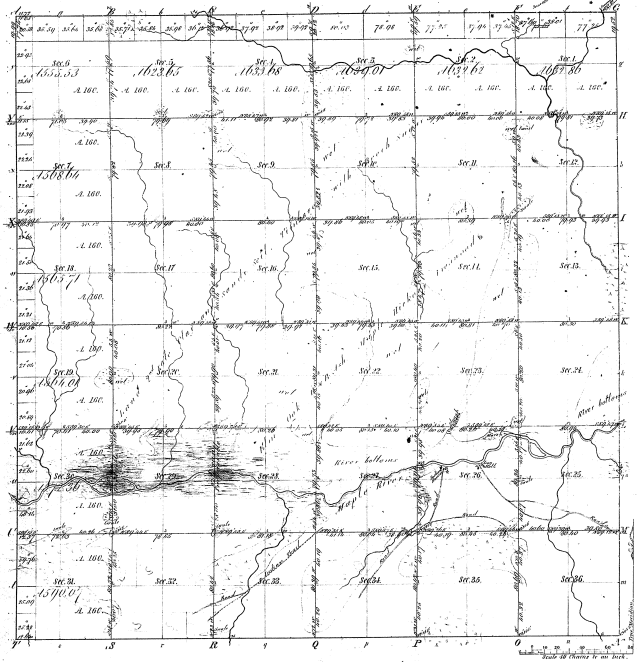

Total number of Acres 22578/14

Surveys Designated	By Whom Surveyed	Date of Contract	Amount of Surveys	When Surveyed	When Plat of Exterior and of the Sub. Div. were Approved
Township lines	Robert Clark Jr.	3rd Nov. 1830	M. 75 78	2nd Quar. 1831	
Subdivisions	Austen Burt	April 18. 1832	58. 31. 54	2nd Quar. 1832	

The above Map of Township 9 y North of Range 1 y 2 West of the Principal Meridian Michigan is strictly conformable to the field notes of the survey thereof on file in this Office, which have been examined and approved.

Surveyor Generals Office
Detroit Oct. 29th 1832

Charles Shultz
Surv. Gen.l

Meanders of							
Posts	Courses	Chs. Lks.	Posts	Courses	Chs. Lks.	Posts	Courses	Chs. Lks.

Note. The Yellow shade represents the water which have been made in this Township.

21

5-16