


Township N. 17 south, Range N. 1 west - Min. (Mich. Terr.)

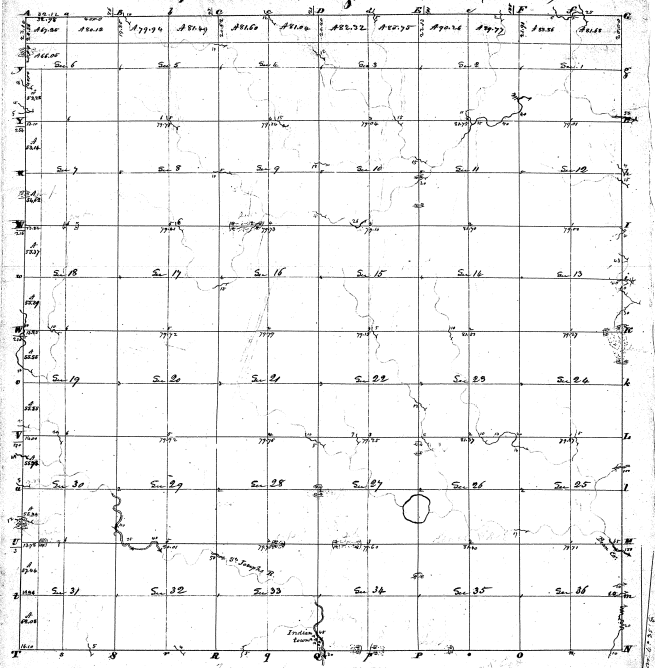

 this plat into the Surveyors General office, certified this 27th day of May 1834.

Robert Clark Jr.

4-27

4-27