


Township N VII south Range N IV west (cont. Tm)

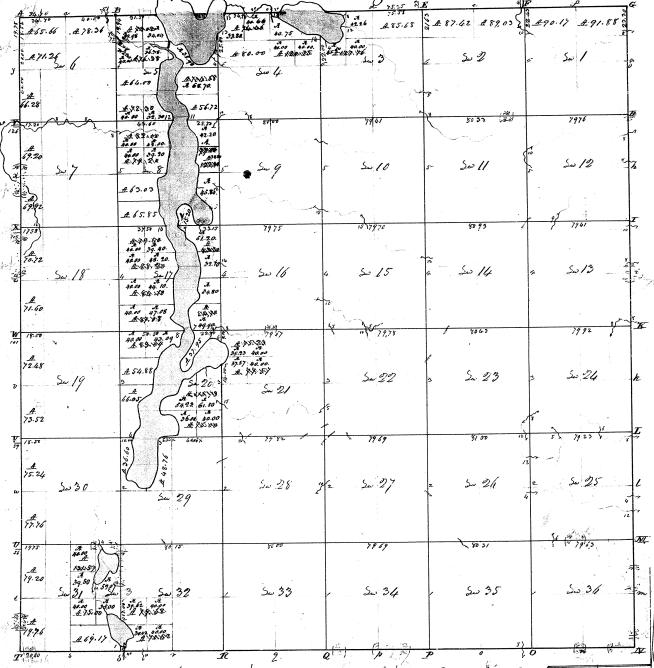

Surveyed in Oct 1885 by William Crossfield S.S.

4-24 35

4-24

