


Township 1^o 9 S. Range 1^o 4 W. Mer.

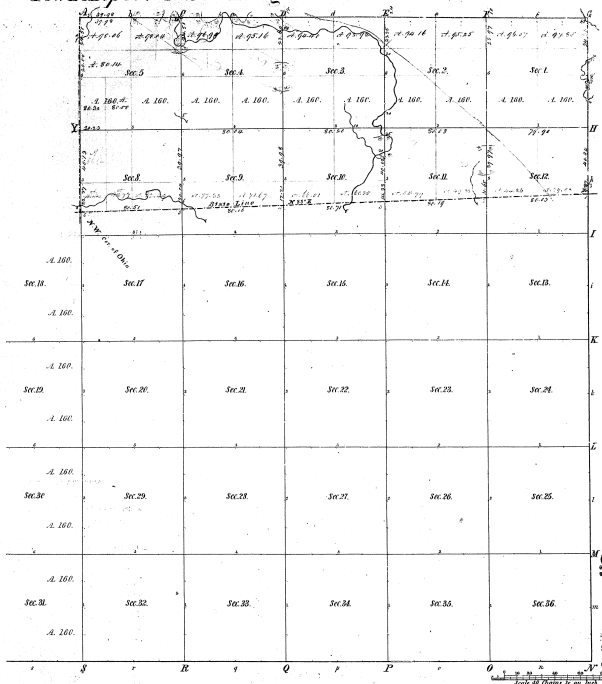

Boundaries of

4-37

4-37

Total number of Acres 5595.57


The above map of Township 1° 9 South of Range 1° 4 West of the Principal Meridian is, in all respects, conformable to the field notes of the survey thereof on file in this Office, which have been examined and approved.

Surveyor General's Office

Lewis A. [Signature]