


Township 1° 48' N. Range 1° 36' W. Mer. Mich.

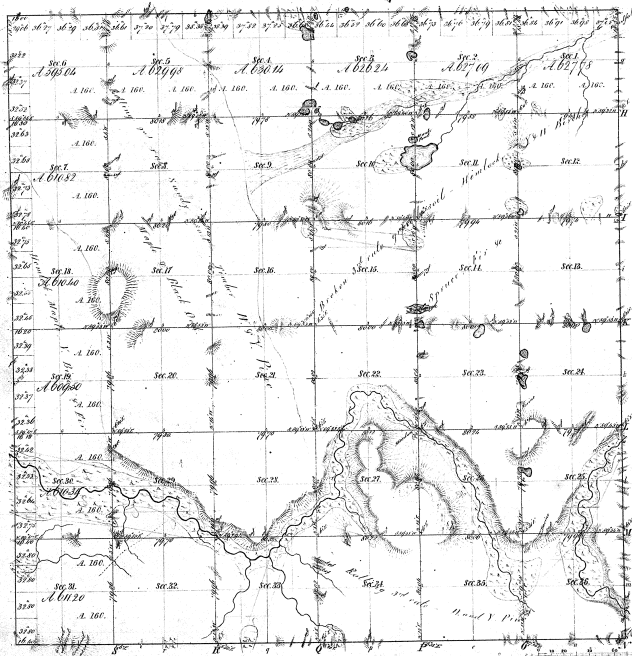

Boundaries of
 First Course 1842^d First Course 1842^d First Course 1842^d

44-

44-9

Total number of acres 27,788.53

Survey designated	By whom surveyed	Date of Contract	Amount of Survey	When Surveyed	When Recd. and at what rate per acre
Township lines	W. H. K. Buel	April 27, 1857	27,788.53	1 st Dec. 1866	
Individuals	J. & L. Mearns	Jan 14, 1857	27,788.53	3 rd Dec. 1861	
	M. N. Hall	Dec 6, 1857	41,460.00	3 rd Dec. 1861	

The above map of Township 1° 48' N. Range 1° 36' W. of the Principal Meridian Michigan is strictly conformable to the field notes of the survey there on file in this office and has been recognized and approved by the Surveyor General's Office.
 Detroit Jan 26, 1863. Charles A. Kille Surveyor