Township. N.o 49 N. Range. N.o 37 W. Mer. Mich.

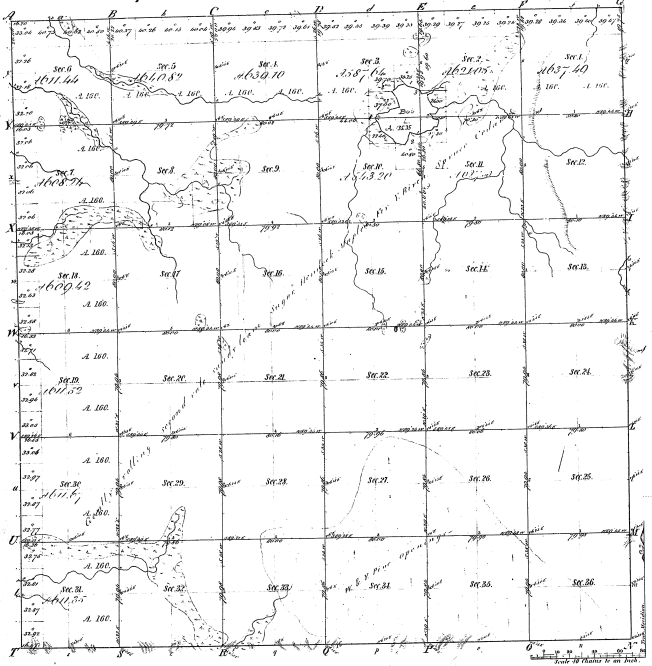

Meanders of

43-5

Total number of Acres 22680 hl.

Surveys Designated	By Whom Surveyed	Date of Contract	Journal of Surveys	When Surveyed	When Offices and A.G. to the Surv. Gen.l rec.d
Township lines	John Black	April 27 1847	11	2nd Quar 1847	
Subdivisions	Solomon Curtis	April 20 1851	60 79 02	2nd 3rd Quars 1851	

The above Map of Township, 49 N. North of Range, 37 West of the Principal Meridian Michigan is strictly conformable to the field notes of the survey thereof on file in this Office, which have been examined and approved.

Surveyor Generals Office,
Detroit Dec. 5. 1851

Surv.r Gen.l