Township N° 52 N. Range N° 36 W. Mer. Mich.

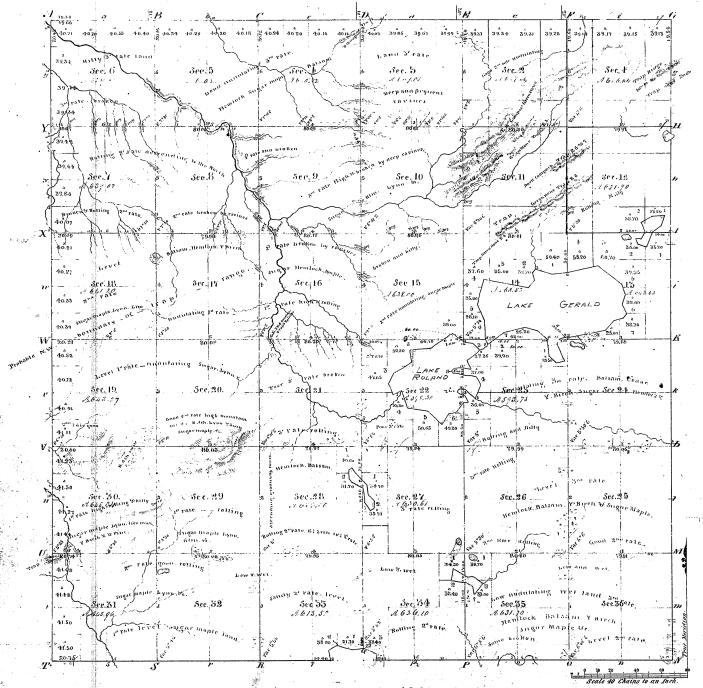

Total number of Acres 22,304.52

Surveys Interpreted.	By Whom Surveyed.	Date of Contract.	Amount of Surveys. M.	Chs	Lks	When Surveyed.	When Charged in the Surveyor-Gen'l acct.
Township lines.	Wm. C. Gould.	June 25th 1846				Sept. 1846	
Subdivisions.	Higgins Wm. Hascall.	April 28th 1846	44	13	85	Sept. 1846	

The above Map of Township N° 52 North of Range N° 36 West of the Principal Meridian, Michigan, is strictly conformable to the field notes of the survey thereof now on file in this Office, which have been examined and approved.

Surveyor Generals Office
Detroit August 18th 1847

Lucius Lyon, Surv. Gen.

Boundary of
Posts | Corners | Chs Lks | Posts | Corners | Chs Lks | Posts | Corners | Chs Lks

41-25