Township N.º 57 N. Range N.º 36 West Mer. Mich.

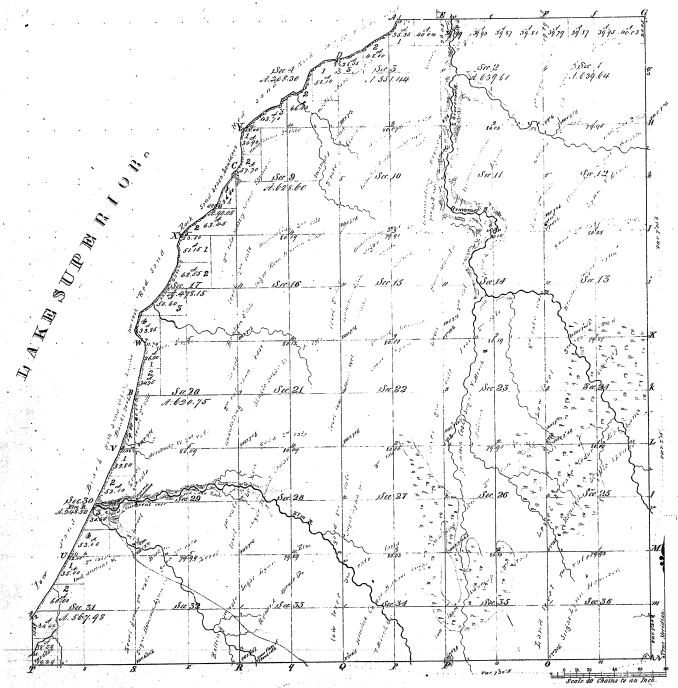

Meanders of

Pairs	Courses	50 LK	Pairs	Courses	50 LK	Pairs	Courses	50 LK

41-12

41-12

Total number of Acres 18143.51

Surveys Designated.	At Whom Surveyed.	Date of Contract.	Amount of Surveys M. Ch's Lks	When Surveyed.	When Charged to the Surr Genl's Office
Township Lines	Wm H. Harrison	June 25 1841	18 79 24	2nd qr 1842	
Subdivisions.	Hazen & Mellendy	Augt 25 1846	56 00 24	3rd qr 1848	

The above Map of Township N.º 57 North of Range N.º 36 West of the Principal Meridian Michigan is strictly conformable to the field notes of the survey thereof on file in the Office, which have been examined and approved.

Surveyor Generals Office
Detroit Oct. 16. 1849

Lucius Lyon, Surr Genl