Township N.o 54 N. Range N.o 37 W. Mer: Mich.

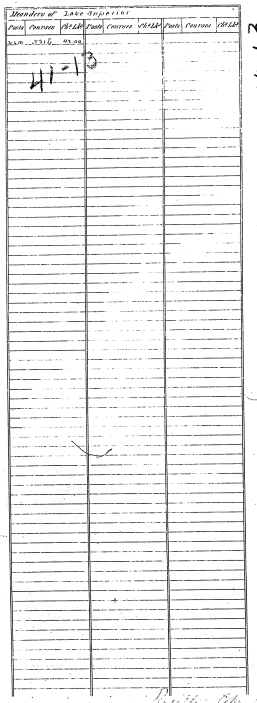

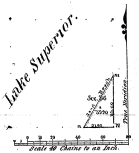

Total number of Acres 39.30

Surveys Designated.	By Whom Surveyed.	Date of Contract.	Amount of Surveys M.	Ch.	Lks.	When Surveyed.	When Charged to the Surveyor Gen.l acct.
Township lines.	Wm. D. Williams	June 25th 1845	5	66		4th qr 1845	
Subdivisions.	Higgins & Holbrook	April 28 1846	32	00		2nd qr 1846	

The above Map of Township C.o 54 North of Range C.o 37 W of the Principal Meridian Michigan is strictly conformable to the field notes of the survey thereof on file in this Office which have been examined and approved.

Surveyor Generals Office. Detroit Octr 16th 1847

Lucius Lyon, Surv.r Gen.l