Township No. 15 N., Range No. 9 E., Mer. Mich.

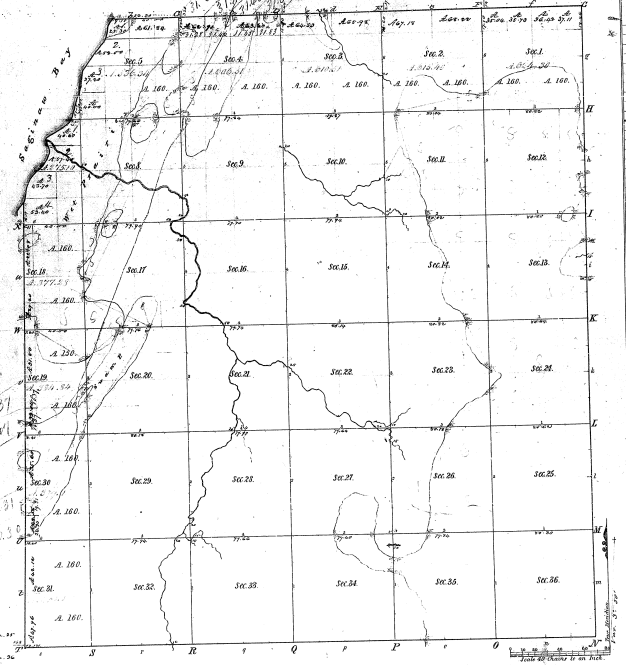

Meanders of Saginaw Bay

Posts	Courses	Dist. Links	Posts	Courses	Dist. Links	Posts	Courses	Dist. Links
...	N 75° E	17.50						
	N 82° E	20.00						
	N 88° E	9.50						
	S 86° 30' E	12.50						
	N 88° E	20.00						
	N 75° E	21.50						
3	N 78° E	16.00						
	N 71° E	17.00						
	N 70° E	9.00						
	N 61° E	8.00						

Total number of Acres.

Surveys Designated	By Whom Surveyed	Date of Contract	Amount of Surveys	When Surveyed	When Plat of ... was returned to the Surr. Gen.'s ...
Township lines	Henry Parker	26 Nov. 1833	M. Ch. Lks. 18 - 44 - 00	1st Qr. 1835	1st Qr. 1835
Subdivisions	George Chadwick	26 Nov. 1833	22 - 17 - 00	1st Qr. 1836	3d Qr. 1836

The above Map of Township No. 15 North of Range No. 9 East of the Principal Meridian Michigan, is strictly conformable to the field notes of the survey thereof on file in this Office, which have been examined and approved.

Surveyor General's Office, Cincinnati.

Surv. Gen.l

24-11