


7 15 A R 11 6

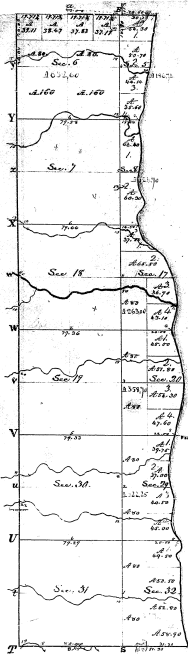

L A K E
H U R O N


25-18

25-18




W. T. Williams
Secy.