Township No. 16 N Range No. 10 E, Mer. Mich.

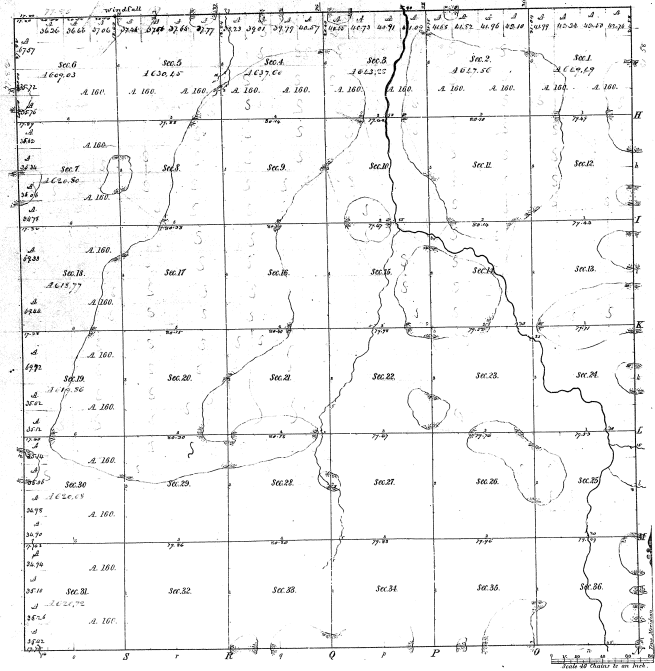

Meanders of

Prairie Courses	Var. E.	Prairie Courses	Var. E.	Prairie Courses	Var. E.

24-7

101

24-7

Total number of Acres 23064

Surveys Designated	By Whom Surveyed	Date of Contract	Amount of Surveys	When Surveyed	When the Surveys of the Sub. Lines were approved	When Returned to the Surveyor Generals Office
Township lines	Alexander Fowler	28th Sept. 1835	24 Days 4/4	1st qr. 1836	3rd qr. 1835	
Subdivisions	Same	11th August 1836	84 " 4/4	2nd qr. 1836	2 qr. 1836	

The above Map of Township No 16 N —— of Ranges No 10 E of the Principal Meridian Michigan is strictly conformable to the field notes of the surveys thereof on file in this Office, which have been examined and approved.

Surveyor Generals Office
Detroit, [illegible]

Surv. Gen.