Township No. 16 N. Range No. 13 E. Mer. Mich.

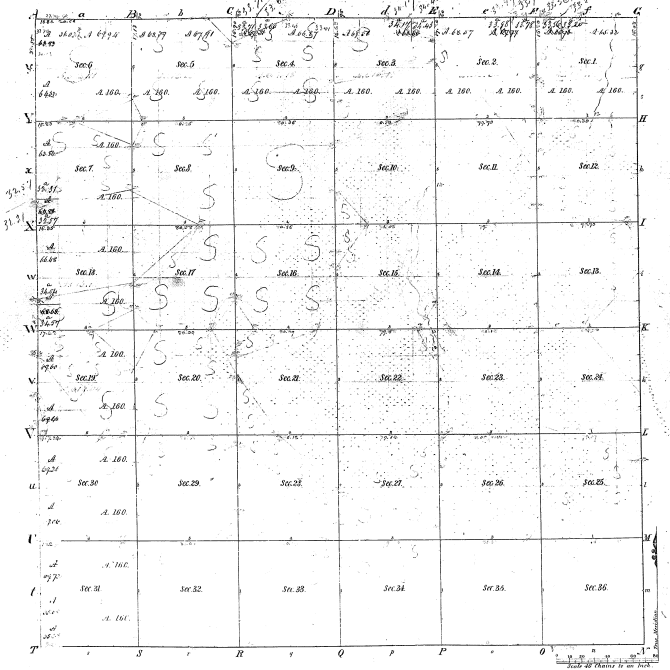

Meanders of							
Poste	Courses	&c &c	Poste	Courses	&c &c	Poste	Courses	&c &c

Surveys Designated	By Whom Surveyed	Date of Contract	Amount of Surveys	When Surveyed	When approved and by whom	When Plat Returned and by whom
Township lines			M. Ch. Lks.			
Subdivisions						

Total number of Acres.

The above Map of Township No. 16 N. of Range No. 13 E. of the Principal Meridian, is strictly conformable to the field notes of the survey thereof on file in this Office, which have been examined and approved.

Surveyor Generals Office, Cincinnati.

Surv. Gen.l