Township No 16 N. Range No 14 E, Mer. Mich.

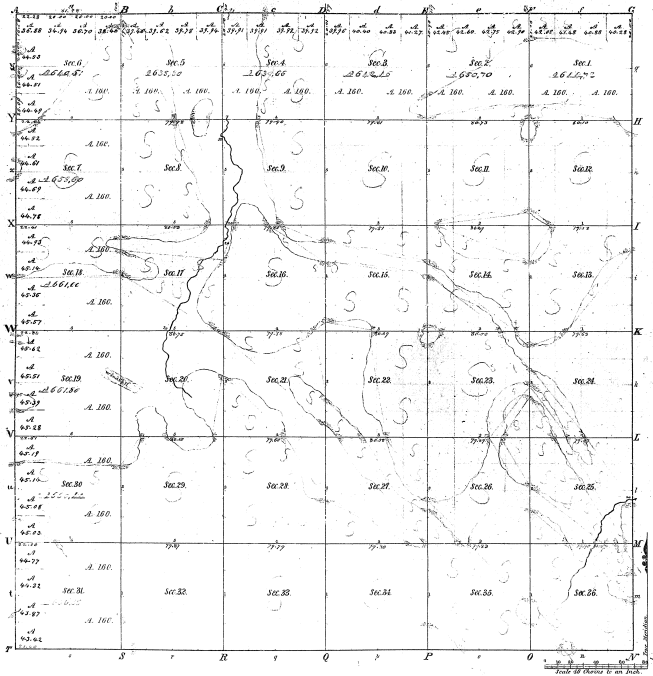

Total number of Acres 23,550

Surveys Designated	By Whom Surveyed	Date of Contract	Amount of Surveys	When Surveyed	When plat'ed and ret'd to the Gen'l Land Office
Township lines	Horace Parker	22nd Nov. 1833	M. 187 Ls. 00	1st to 7th Dec. 1834	31st Dec. 1835
Subdivisions	N. Edwards & C. H. Hay	11th May 1834	22. 14. 32	2nd Dec. 1834	4th Jan. 1836

The above Map of Township No 16 North of Range No 14 East of the Principal Meridian Mich. is strictly conformable to the field notes of the survey thereof on file in this Office which have been examined and approved.

Surveyor Generals Office,
Cincinnati,

Surv. Gen.l

Meanders of							
Pools	Courses	Or. Lks	Pools	Courses	Or. Lks	Pools	Courses	Or. Lks

25-11