


Township No 17 N, Range No 10 W Mer Mich.

ML 24-4

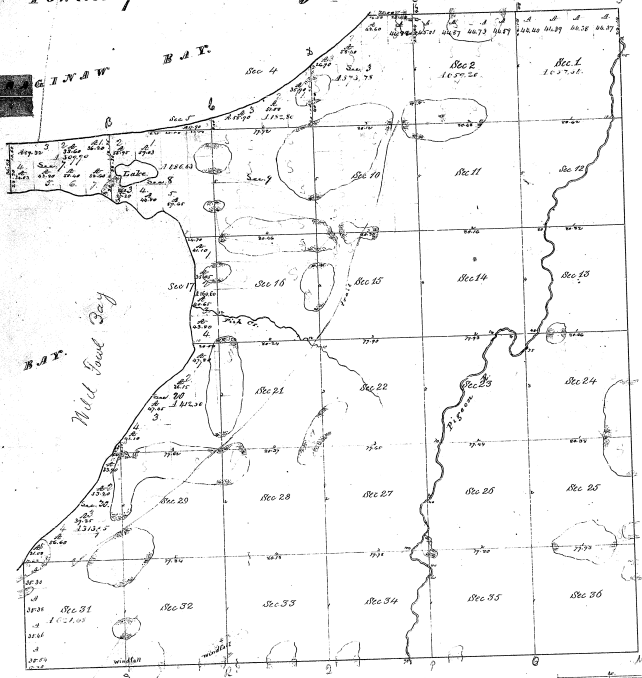









From lines Surveyed for 1833 12-14-37  
 and 1835 12-14-37  

The above map of Township No 17 N Range No 10 W Mer Mich. is hereby confirmed to the field notes of the survey thereof, on file in this office, which have been examined and approved.  
 Surveyor General's Office  
 Cincinnati

24-4