# Township No. 17 N. Range No. 11 E. Mer. Mich.

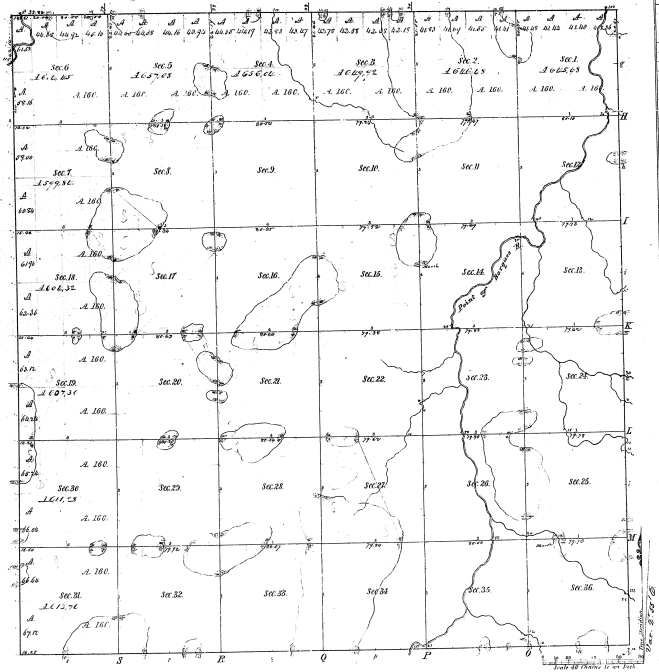


Meanders of South Courses

| Surveys Designated | By whom Surveyed | Date of Contract | Total number of Acres surveyed or Surveys | When Surveyed | When plats and field notes were returned |
|---|---|---|---|---|---|
| Township lines | Harvey Parker | 28th Nov. 1833 | N. 153 Ch. 63.72.67 | 1st Qr. 1835 | 3rd Qr. 1835 |
| Subdivisions | James | 11 Aug. 1834 | 87.66.12 | 4th Qr. 1835 | 3rd Qr. 1836 |

The above Map of Township No. 17 N. of Range No. 11 E. of the Principal Meridian Michigan is truly copied from the field notes of the survey thereof on file in this Office which have been examined and approved.

Surveyor Generals Office, Cincinnati.

Surveyor General