Township No. 17 N. Range No. 13 E. Mer. Mich.

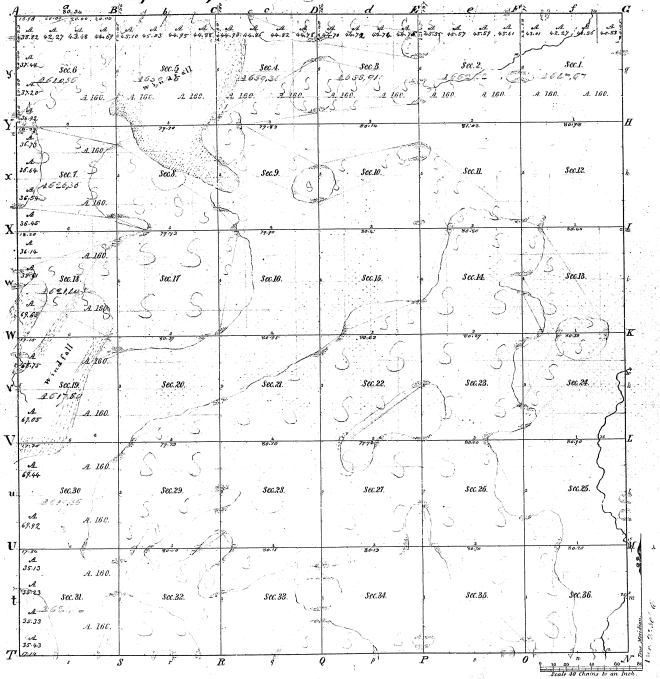

Meanders of

Posts	Courses	Ch. Lk.	Posts	Courses	Ch. Lk.	Posts	Courses	Ch. Lk.

Total number of Acres 23003.12

Surveys Designated	By Whom Surveyed	Date of Contract	Amount of Surveys	When Surveyed	When & Co. and ch. in the Surr. Gen.'s out	
Township lines	[illegible]	20th Sep. 1825	M. Ch. Lk. 48 - 00 - 00	8th Sep. 1826	5th 1828	
Subdivisions	J. [illegible]	16th Jul. 1825	60 - 01 - 08	8th Sep. 1826	12th Sep. 1825	

The above Map of Township No. 17 N. of Range No. 13 E. of the Principal Meridian Michigan, is strictly conformable to the field notes of the survey thereof on file in this Office, which have been examined and approved.

Surveyor General's Office,
Cincinnati.

Sur. Gen.l