Township No 18 N., Range No 10 E Mer Mich.

24-1

Dist	Courses	Ch.	Dist	Courses	Ch. Lks
1	S 69 W	20.00	6	S 43 W	22.50
2	S 18 W	17.50		S 15 W	17.00
	S 84 W	14.00		S 27 W	8.67
	N W	12.50		S 34 W	22.50
	S 23 W	7.50		S 49 W	16.50
	South	7.50	6	S 60 W	8.50
3	S 15 W	2.00			
				S 43 W	28.50
	S 55 W	11.50		S 67 W	15.50
4	S 69 W	18.00	7	S 89 W	10.00
	S 84 W	11.33			

Meanders of 2 Lakes in Sec 24					
	N 8 E	18.00		S 83 E	3.50
	N 17 E	12.00		S 63 W	8.50
	N 39 E	11.50		S 89 W	7.00
	N 63 E	6.50		S E	5.00
	N 17 W	6.00		S 20 W	8.00
	N 37 W	16.50		S 36 W	8.00
	N 54 W	3.50		S 11 W	2.50
	N W	12.00		S 4 E	5.00
	N 18 E	3.00		S 11 W	4.50
	N 18 E	11.50		S 11 W	6.50
	N 41 E	10.50		S 17 W	3.00
	N 32 E	7.50		N 75 W	3.50

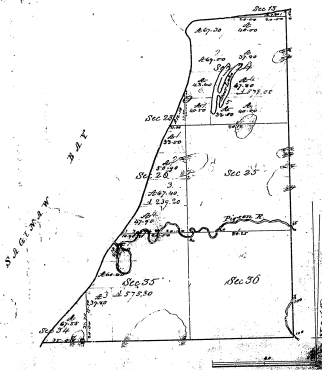

Total number of Acres 2760.45

Townships Designation	By whom Surveyed	Date of Contract	Date of Survey	When Returned to Gen. Land Office	When Noted & Plotted	The above Plat of Township No 18 N. Range No 10 E Mer.
Town Lines Subdivisions	Murray Tabor Jones	22 Oct 1833 11 May 1833	S. 27 - 30 W. 29 - 31	1 Aug 1836 2 Aug 1835	29 Aug 1836 2 Aug 1836	is a true and correct copy of the original plat of the Survey thereof on file in this Office, which has been examined & approved. Surveyor General's Office Detroit 29th Aug 1836