Township No. 18 N. Range No. 13 E. Mer. Mich.

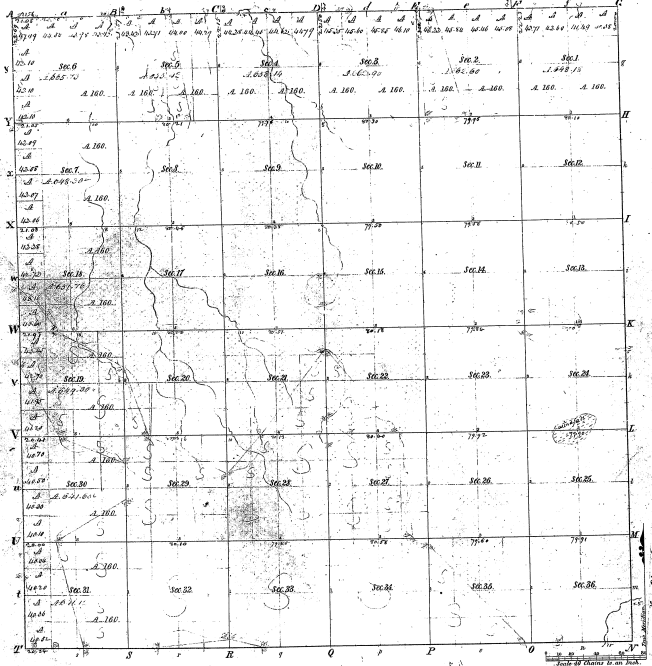

Meanders of							
Pond	Courses	Ch. Lks.	Ponds	Courses	Ch. Lks.	Ponds	Courses	Ch. Lks.

25-3

Total number of Acres.												
Surveys Designated.	By Whom Surveyed.	Date of Contract	Amount of Surveys			When Surveyed			Whose fractions and in the Sur. Gen.l use.			
Township lines	Surveyor No. 6	Jan. 22 1833	23	25	16	1834			1834			
Subdivisions	Surveyor No. 6	April 11 1836	60	15	85	1834	1835		2	2	1.36	

The above Map of Township No. 18 N. of Range No. 13 East of the Principal Meridian, Mich. is strictly conformable to the field notes of the surveys thereof on file in this Office, which have been examined and approved.

Surveyor Generals Office, Cincinnati, [illegible] Surv. Gen.l