Township N. 11 north, Range N. 1 east (Kind. Tsp.)

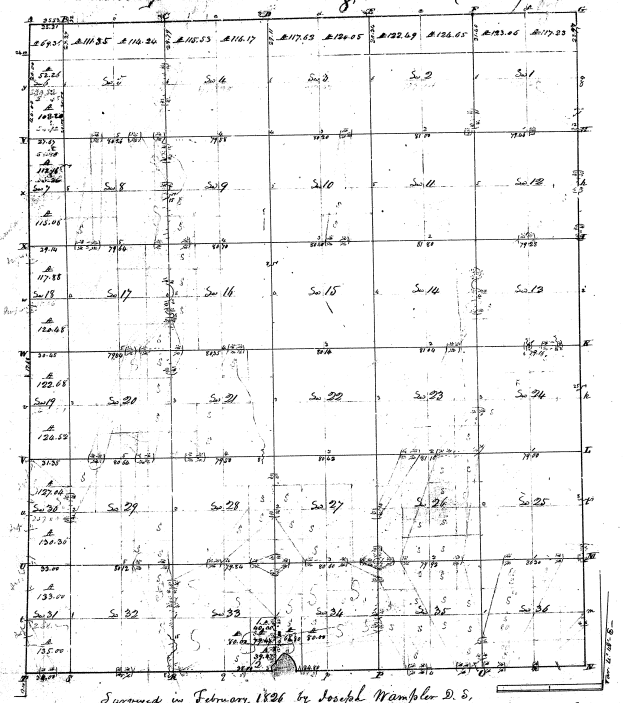

Surveyed in February 1826 by Joseph Wampler D. S.

Total C. L. 21.036.69

29-33

Table of Contents

Sections	Acres	hds	Sections	Acres	hds
Fr N E 1	117	23	N E 31	133	
Sx "	80		S E "	135	
Fr N W "	123	06	Sec 32	640	
Sx "	80		Fr 33	320	
" "	320		Sx "	80	
Fr N E 2	124	65	Fr "	80	
Sx "	80		S W "	160	
Fr N W "	122	49	Fr 34	320	
Sx "	80		S E "	160	
" "	320		Sx S W "	80	
Fr N E 3	120	05	Fr "	86	80
Sx "	80		Sec 35	640	
Fr N W "	117	68	36	640	
Sx "	80			3464	32
" "	320			17382	60
Fr N E 4	116	17		20851	07 Total
Sx "	80				
Fr N W "	115	53			
Sx "	80				
" "	320				
Fr N E 5	114	20			
Sx "	80				
Fr N W "	111	35			
Sx "	80				
" "	320				
Fr N E 6	69	38			
Sx "	52	26			
S E "	108	20			
N E "	102	76			
S E "	115	08			
Sec 5	640				
9	640				
10	640				
11	640				
12	640				
13	640				
14	640				
15	640				
16	640				
17	640				
N E 18	117	88			
S E "	120	48			
N E 19	122	68			
S E "	120	52			
Sec 20	640				
21	640				
22	640				
23	640				
24	640				
25	640				
26	640				
27	640				
28	640				
29	640				
N E 30	124	04			
S E "	130	56			
	17382	60			